

Luce County Remonumentation Program

1993

LAND CORNER RECORDATION CERTIFICATE
Filing Requirement of Act 74, Mich. P.A. 1970

COMMISSION

For corners in

Luce

(County)

Located In:

Corner Code #

- | | | |
|------------------------------------|---------------------------|------------|
| 1. Public Land Survey | T <u>45N</u> R <u>12W</u> | <u>F-9</u> |
| | T _____ R _____ | _____ |
| | T _____ R _____ | _____ |
| | T _____ R _____ | _____ |
| 2. Property Controlling in Section | S _____ T _____ R _____ | _____ |
| | S _____ T _____ R _____ | _____ |
| 3. Miscellaneous Property in Sec. | S _____ T _____ R _____ | _____ |
| | S _____ T _____ R _____ | _____ |

Filed 12-22 A.D., 1993

At 10:00 o'clock A.M.

Liber 2
File No. page 52

William L. Karr
Luce County Reg. of Deeds

Register of Deeds Stamp & File Number

4. Lot No. _____, Recorded Plat _____
5. Private Claims _____

	A	B	C	D	E	F	G	H	I	J	K	L	M
2	6		5		4		3		2		1		
3													
4	7		8		9		10		11		12		
5													
6	13		17		16		15		14		13		
7													
8	19		20		21		22		23		24		
9													
10	30		29		28		27		26		25		
11													
12	31		32		33		34		35		36		
13													

I, William L. Karr, in a field survey on November 12, 19 93, do hereby certify that under requirements of P.A. 74, Michigan P.A. of 1970, the corner points mentioned in lines 1 and 2 above were in conformance with regulations and rules therefore as required in the current manual of survey instructions of the United States Department of the Interior, Bureau of Land Management or by a decree of a Court of Law and/or that the corner points mentioned in lines 3, 4 and 5 above were in conformance with the rules of the Michigan Board of Land Surveyors or by a Decree of a Court of Law; established, re-established, monumented, re-monumented, recovered, found as expressed below:

NOTE: Not more than 4 corners, all in the same town and range, may be recorded on this certificate.

A. Description of original monument and accessories and/or subsequent restoration:
(F-9) 1/4 Corner Sections 21 & 28, T45N-R12W

1849: Corner established by Guy H. Carleton
Set 1/4 Section Post
Sugar 12 N 57 E 25 links
Beech 6 S 58 W 19 links

B. Description of corner evidence found and/or method applied in restoring or reestablishing corner:


Corner reestablished as part of the Luce County Remonumentation Program. Reestablished corner position midway and on line between the Northeast and Northwest corners of Section 28.

Reestablished corner position checks well with the apparent Center 1/4 Corner of Section 28 and the apparent Meander Corner on the South end of the North-South 1/4 Line of Section 28. At both corner locations found a 4" square concrete monument with a 1/2" iron.

C. Description of monument for corner and accessories established to perpetuate locating the position of the corner:

Corner is a 1/2" x 24" iron with a 3 1/4" diameter stamped aluminum cap, 1' below paved road surface. Falls 1.2' South of the North edge of pavement (11' North of centerline) of County Road H-44(98) (East-West, paved). Falls 4' West of extension of centerline of two track farm lane to the South.

Power Pole	S79°E	207.55'
"V" Notch in East End of 12" C.M.P.	S35°E	46.80'
Power Pole	S74°W	227.36'
"V" Notch in East End of 12" C.M.P.	N08°W	11.69'

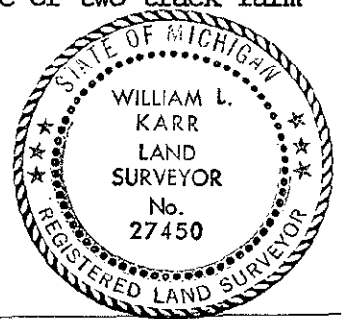

Signed by William L. Karr Date 12/16/93

Surveyor's Michigan License No. 27450

NOTE: Bearings are compass bearings corrected for declination. Distances are to a nail with P.S. 27450 tag in side of witness objects unless noted.