

Luce County Remonumentation Program

1993

LAND CORNER RECORDATION CERTIFICATE
Filing Requirement of Act 74, Mich. P.A. 1970

COMMISSION

For corners in

<u>Luce</u> (County)	Located In:	Corner Code #
1. Public Land Survey	T <u>45N</u> R <u>12W</u>	<u>G-8</u>
	T _____ R _____	_____
	T _____ R _____	_____
	T _____ R _____	_____
2. Property Controlling in Section	S _____ T _____ R _____	_____
	S _____ T _____ R _____	_____
3. Miscellaneous Property in Sec.	S _____ T _____ R _____	_____
	S _____ T _____ R _____	_____
4. Lot No. _____, Recorded Plat _____		
5. Private Claims _____		

Filed 12-22 A.D., 1993

At 10:00 o'clock A.M.

Liber 2
File No. page 514

Walter S. Maler
Luce County Reg. of Deeds

Register of Deeds Stamp & File Number

	A	B	C	D	E	F	G	H	I	J	K	L	M
2	6	5	4	3	2	1							
3													
4	7	8	9	10	11	12							
5													
6	18	17	16	15	14	13							
7													
8	19	20	21	22	23	24							
9													
10	30	29	28	27	26	25							
11													
12	31	32	33	34	35	36							
13													

I, William L. Karr, in a field survey on November 10, 1993, do hereby certify that under requirements of P.A. 74, Michigan P.A. of 1970, the corner points mentioned in lines 1 and 2 above were in conformance with regulations and rules theretore as required in the current manual of survey instructions of the United States Department of the Interior, Bureau of Land Management or by a decree of a Court of Law and/or that the corner points mentioned in lines 3, 4 and 5 above were in conformance with the rules of the Michigan Board of Land Surveyors or by a Decree of a Court of Law; established, re-established, monumented, re-monumented, recovered, found as expressed below:

NOTE: Not more than 4 corners, all in the same town and range, may be recorded on this certificate.

A. Description of original monument and accessories and/or subsequent restoration:

(G-8) 1/4 Corner Sections 21 & 22, T45N-R12W

1849: Corner established by Guy H. Carleton
Sugar 6 N 86 E 19 links
Sugar 12 S 63 W 12 links

B. Description of corner evidence found and/or method applied in restoring or reestablishing corner:


Corner reestablished as part of the Luce County Remonumentation Program.

Found a 2" O.D. x 8" pipe split in half (manufactured split). Found pipe in ground at an angle. Found remains of East-West fence line on East side of road. Found remains of right-of-way fences on East & West sides of road (66' apart). A prorated position for the corner falls on the extension of the fence line to East. Did not hold pipe. Reestablished corner position midway between the Northwest and Southwest corners of Section 22 and at a split of the right-of-way fences. Corner falls 6.16' West of a straight line between said section corner. Found pipe is S14°W - 3.05' from reestablished corner position. Removed pipe.

C. Description of monument for corner and accessories established to perpetuate locating the position of the corner:

Corner is a 1/2" x 24" iron with a 3 1/4" diameter stamped aluminum cap, 6" below gravel road surface. Falls in centerline of County Road 436 (North-South, gravel). Falls on extension of remains of fence line to East.

4" Elm	N08°E	162.65'
Power Pole	N88°E	34.70'
Drill Hole in North End of 12" Concrete Culvert	S08°E	116.20'
10" White Birch in Clump	N44°W	31.17'
6" Basswood in Clump	N06°W	173.76'

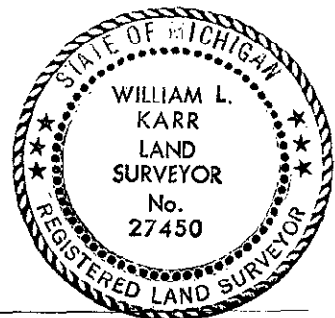

Signed by William L. Karr Date 12/16/93

Surveyor's Michigan License No. 27450

NOTE: Bearings are compass bearings corrected for declination. Distances are to a nail with P.S. 27450 tag in side of witness objects unless noted.