

Luce County Remonumentation Program

1993

LAND CORNER RECORDATION CERTIFICATE
Filing Requirement of Act 74, Mich. P.A. 1970

COMMISSION

For corners in

<u>Luce</u> <small>(County)</small>	Located In:	Corner Code #	
1. Public Land Survey	T <u>45N</u> R <u>12W</u>	<u>G-9</u>	
	T _____ R _____	_____	
	T _____ R _____	_____	
	T _____ R _____	_____	
2. Property Controlling in Section	S _____ T _____ R _____	_____	
	S _____ T _____ R _____	_____	
3. Miscellaneous Property in Sec.	S _____ T _____ R _____	_____	
	S _____ T _____ R _____	_____	
4. Lot No. _____, Recorded Plat _____			
5. Private Claims _____			


Filed 12-22 A.D., 1993

At 10:00 o'clock A. M.

Liber 2
File No. page 515

Arthur S. Mahan
Luce County Reg. of Deeds

Register of Deeds Stamp & File Number

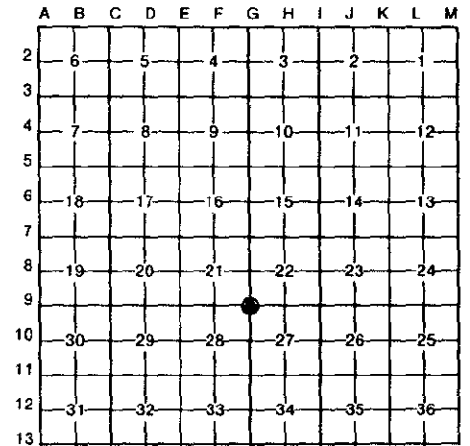

I, William L. Karr in a field survey on October 5, 1993 do hereby certify that under requirements of P.A. 74, Michigan P.A. of 1970, the corner points mentioned in lines 1 and 2 above were in conformance with regulations and rules therefore as required in the current manual of survey instructions of the United States Department of the Interior, Bureau of Land Management or by a decree of a Court of Law and/or that the corner points mentioned in lines 3, 4 and 5 above were in conformance with the rules of the Michigan Board of Land Surveyors or by a Decree of a Court of Law; established, re-established, monumented, re-monumented, recovered, found as expressed below:

NOTE: Not more than 4 corners, all in the same town and range, may be recorded on this certificate.

A. Description of original monument and accessories and/or subsequent restoration:
(G-9) Section Corner Sections 21, 22, 27 & 28, T45N-R12W

1849: Corner established by Guy H. Carleton
Set post
Yellow Birch 10 N 50 W 35 links
Yellow Birch 6 S 10 E 10 links


B. Description of corner evidence found and/or method applied in restoring or reestablishing corner:
Corner reestablished as part of the Luce County Remonumentation Program.

Reestablished corner position using found corners to the South. Found a "T" iron with I.S. 7873 cap (Eino Sainio) at the 1/4 Corner Sections 27 & 28 and 664.09' to the North at the Northeast corner of the South 1/2 of the Southeast 1/4 of the Northeast 1/4 of Section 28. Extended the line North an additional 1992.27' to reestablish Section Corner 21, 22, 27 & 28. Position works well with existing East-West paved road and gravel road to the North.

C. Description of monument for corner and accessories established to perpetuate locating the position of the corner:
Corner is a 1/2" x 18" iron with a 3 1/4" diameter stamped aluminum cap, 1" below paved road surface. Falls 1' South of centerline County Road H-44(98) (East-West, paved). Falls 2' West of centerline County Road 436 to North (North-South, gravel) Falls on approximate extension of fence line to South (North end of fence is approximately 600 feet to the South).

6" Tamarack	N22°E	167.03'
20" Maple	N48°E	93.48'
Power Pole NY3/196	S50°E	48.67'
6" Spruce	N44°W	171.37'
5" Spruce	N16°W	133.26'

Signed by William L. Karr Date 12/16/93
Surveyor's Michigan License No. 27450

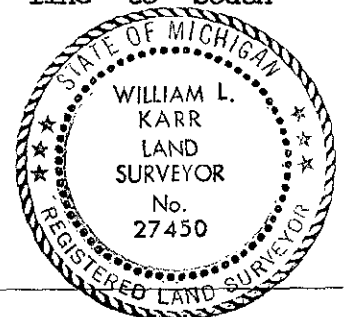

NOTE: Bearings are compass bearings corrected for declination. Distances are to a nail with P.S. 27450 tag in side of witness objects unless noted.