

MAR 13 2000

LAND CORNER RECORDATION CERTIFICATE
Filing Requirement of Act 74, Mich. P.A. 1970
Luce County Remonumentation Corner


SECTION

For corners in

Luce County	Located in:	Corner Code #
1. Public Land Survey	T45N R12W	G-11
	T R	
	T R	
	T R	
2. Property Controlling in Section	S T R	
	S T R	
3. Miscellaneous Property in Sec.	S T R	
	S T R	
4. Lot No.		Recorded Plat
5. Private Claims		

LUCE COUNTY
REGISTER OF DEEDS
Recorded
Liber 3 Page 879
02-08-2000 08:27:41
Kathy S. Mahan
Kathy S. Mahan, Register
REGISTER OF DEEDS

Register of Deeds Stamp & File Number

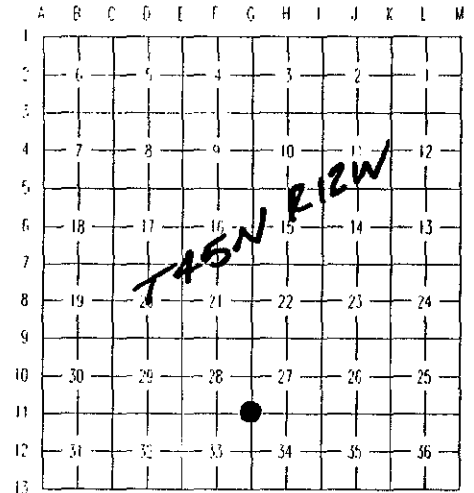

I, William L. Karr, in a field survey on November 12, 1999, do hereby state that under requirements of P.A. 74, Michigan P.A. of 1970, the corner points mentioned in lines 1 and 2 above were in conformance with regulations and rules therefore as required in the current manual of survey instructions of the United States Department of the Interior, Bureau of Land Management or by a decree of a Court of Law and /or that the corner points mentioned in lines 3, 4 and 5 above were in conformance with the rules of the Michigan Board of Land Surveyors or by a Decree of a Court of Law; established, re-established, monumented, recovered, found as expressed below:


NOTE: Not more than 2 corners, all in the same town and range, may be recorded on this certificate.

A. Description of original monument and accessories and/or subsequent restoration:

(G-11) Section Corner Common to Sections 27, 34, 33 and 28, Township 45 North, Range 12 West.

1849 G.H. Carleton set post for corner in original survey. Witnesses: Ironwood 6" N28°E 23 lks
Sugar 14" S60°W 16 lks

Found no subsequent survey history on this corner in available public records.

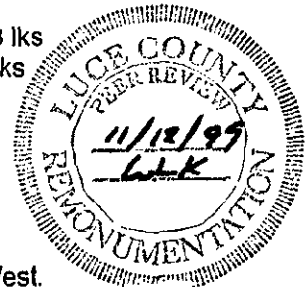

B. Description of corner evidence found and/or method applied in restoring or reestablishing corner:

(G-11) Section Corner Common to Sections 27, 34, 33 and 28, Township 45 North, Range 12 West.

This corner is being perpetuated as part of the Luce County Remonumentation Program.

Found no evidence of the original corner or of subsequent restoration. Re-established the corner by extending the line between Section Corner 21, 22, 27 and 28 and 1/4 Corner 27 and 28, South a distance of 2656.37 feet, (the same distance as the North 1/2 mile). Distance East is 5280.07 feet (G.L.O. 5280.0 feet). Meander corners South and West of this position were established at record G.L.O. distances and fit extremely well with existing shore line.

C. Description of monument for corner and accessories established to perpetuate locating the position of the corner:

(G-11) Section Corner Common to Sections 27, 34, 33 and 28, Township 45 North, Range 12 West.

Corner is a 1/2" x 48" re-rod with a stamped aluminum Luce County Remonumentation Cap.

Witnesses:

Red Maple 20"	S82°E	32.26 feet
Sugar Maple 14"	S16°E	28.04 feet
Sugar Maple 15"	S82°W	39.51 feet
Red Maple 22"	N26°W	29.14 feet



Bearings are compass bearings, corrected for declination (6° W), all distances are to a nail and tag in the side of the witness object unless otherwise noted.

Signed by *William L. Karr*

Date 12/24/99

Surveyor's Michigan License No. 27450