

Luce County Remonumentation Program

COMMISSION

LAND CORNER RECORDATION CERTIFICATE
Filing Requirement of Act 74, Mich. P.A. 1970


For corners in

<u>Luce</u> (County)	Located in:	Corner Code #
1. Public Land Survey	T <u>45N</u> R <u>12W</u>	<u>H-9</u>
	T _____ R _____	_____
	T _____ R _____	_____
	T _____ R _____	_____
2. Property Controlling in Section	S _____ T _____ R _____	_____
	S _____ T _____ R _____	_____
3. Miscellaneous Property in Sec.	S _____ T _____ R _____	_____
	S _____ T _____ R _____	_____
4. Lot No. _____, Recorded Plat _____		
5. Private Claims _____		

Filed 12-22 A.D., 1993
 At 10:00 o'clock A.M.
 Liber 2
 File No. page 518
Walter S. Mahan
 Luce County Reg. of Deeds

Register of Deeds Stamp & File Number

I, William L. Karr, in a field survey on October 6, 1993, do hereby certify that under requirements of P.A. 74, Michigan P.A. of 1970, the corner points mentioned in lines 1 and 2 above were in conformance with regulations and rules therefore as required in the current manual of survey instructions of the United States Department of the Interior, Bureau of Land Management or by a decree of a Court of Law and/or that the corner points mentioned in lines 3, 4 and 5 above were in conformance with the rules of the Michigan Board of Land Surveyors or by a Decree of a Court of Law; established, re-established, monumented, re-monumented, recovered, found as expressed below:

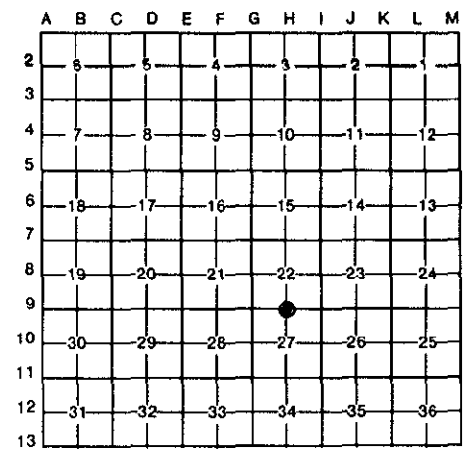

NOTE: Not more than 4 corners, all in the same town and range, may be recorded on this certificate.

A. Description of original monument and accessories and/or subsequent restoration:
(H-9) 1/4 Corner Sections 22 & 27, T45N-R12W

1849: Corner established by Guy H. Carleton
 Set 1/4 Section Post
 Sugar 8 N 63 E 32 links
 Beech 9 S 36 W 33 links

B. Description of corner evidence found and/or method applied in restoring or reestablishing corner:
Corner reestablished as part of the Luce County Remonumentation Program.

Found a North-South fence line on North side of road. Daniel Kenny, a local land owner (SW 1/4 of Section 22), stated that the fence line represented the property line. Reestablished corner position on line between the Northeast and Northwest corners of Section 27 on the extension of fence line to North. Distance East to the Northeast corner of Section 27 is 2641.27'. Distance West to the Northwest corner of Section 27 is 2645.39'.

C. Description of monument for corner and accessories established to perpetuate locating the position of the corner:
Corner is a 1/2" x 24" iron with a 3 1/4" diameter stamped aluminum cap, 1" below paved road surface. Falls 3.5' South of centerline of County Road H-44(98) (East-West, Paved). Falls on extension of fence line to the North.

8" Cherry Tree	N34°E	118.39'
7" Balsam Fir	S23°E	59.50'
10" Maple	S24°W	60.34'
6" Aspen	N38°W	68.35'



Signed by William L. Karr Date 12/18/93

Surveyor's Michigan License No. 27450

NOTE: Bearings are compass bearings corrected for declination. Distances are to a nail with P.S. 27450 tag in side of witness objects unless noted.