

Luce County Remonumentation Program

1993

LAND CORNER RECORDATION CERTIFICATE
Filing Requirement of Act 74, Mich. P.A. 1970

COMMISSION

For corners in

<u>Luce</u> (County)	Located in:	Corner Code #
1. Public Land Survey	T <u>45N</u> R <u>12W</u>	<u>I-7</u>
	T _____ R _____	_____
	T _____ R _____	_____
	T _____ R _____	_____
2. Property Controlling in Section	S _____ T _____ R _____	_____
	S _____ T _____ R _____	_____
3. Miscellaneous Property in Sec.	S _____ T _____ R _____	_____
	S _____ T _____ R _____	_____

Filed 12-22 A.D., 1993


At 10:00 o'clock A. M.

Libel 2
File No. Page 519

Walter S. D. Mahan
Luce County Reg. of Deeds

Register of Deeds Stamp & File Number

4. Lot No. _____, Recorded Plat _____
5. Private Claims _____

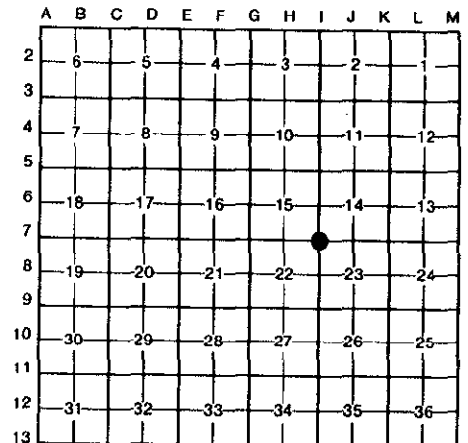

I, William L. Karr, in a field survey on September 16, 1993, do hereby certify that under requirements of P.A. 74, Michigan P.A. of 1970, the corner points mentioned in lines 1 and 2 above were in conformance with regulations and rules therefore as required in the current manual of survey instructions of the United States Department of the Interior, Bureau of Land Management or by a decree of a Court of Law and/or that the corner points mentioned in lines 3, 4 and 5 above were in conformance with the rules of the Michigan Board of Land Surveyors or by a Decree of a Court of Law; established, re-established, monumented, re-monumented, recovered, found as expressed below:

NOTE: Not more than 4 corners, all in the same town and range, may be recorded on this certificate.

A. Description of original monument and accessories and/or subsequent restoration:

(I-7) Section Corner Sections 14, 15, 22 & 23, T45N-R12W

1849: Corner established by Guy H. Carleton

Set Post

Beech 6 S 43 E 4 links

Beech 8 N 66 W 22 links

B. Description of corner evidence found and/or method applied in restoring or reestablishing corner:


Corner perpetuated as part of the Luce County Remonumentation Program.

Found a bent 5/8" iron. Falls in intersecting road centerlines. Offset iron and pulled. Found 2 spikes in immediate area. Found a 1 3/4" O.D. pipe in the Southwest quad. Pipe not the same type as other witness corner pipes found in the area. Could not find a witness corner in the Northeast quad. Accepted corner position as found. Replaced existing iron with a 1/2" x 24" iron with a 3 1/4" diameter stamped aluminum cap. Set a 10" spike in pipe.

C. Description of monument for corner and accessories established to perpetuate locating the position of the corner:

Corner is a 1/2" x 24" iron with a 3 1/4" diameter stamped aluminum cap, 4" below paved road surface. (Intersection paved, gravel over pavement). Falls in intersecting road centerlines of County Road 436 (East-West, gravel), County Road 459 to South (North-South, gravel) and two track road to North (Gated).

Wood Fence Post	N16°E	36.69'
12" Cherry Tree of Twin	S62°E	61.21'
1 3/4" O.D. Pipe	S46°W	43.06'
7" Aspen	S68°W	78.45'
Power Pole NY3/182/16	N50°W	46.64'
6" Red Pine	N16°W	62.27'

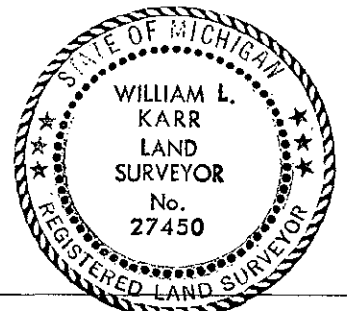

Signed by William L. Karr Date 12/16/93

Surveyor's Michigan License No. 27450

NOTE: Bearings are compass bearings corrected for declination. Distances are to a nail with P.S. 27450 tag in side of witness objects unless noted.