

Luce County Remonumentation Program

1993

LAND CORNER RECORDATION CERTIFICATE
Filing Requirement of Act 74, Mich. P.A. 1970

COMMISSION

For corners in

Luce (County)	Located In:	Corner Code #
1. Public Land Survey	T <u>45N</u> R <u>12W</u>	<u>I-9</u>
	T _____ R _____	_____
	T _____ R _____	_____
	T _____ R _____	_____
2. Property Controlling in Section	S _____ T _____ R _____	_____
	S _____ T _____ R _____	_____
3. Miscellaneous Property in Sec.	S _____ T _____ R _____	_____
	S _____ T _____ R _____	_____

Filed 12-22 A.D., 1993


At 10:00 o'clock A. M.

File No. 4096 521

Walter S. Mahan
Luce County Reg. of Deeds

Register of Deeds Stamp & File Number

4. Lot No. _____, Recorded Plat _____
5. Private Claims _____

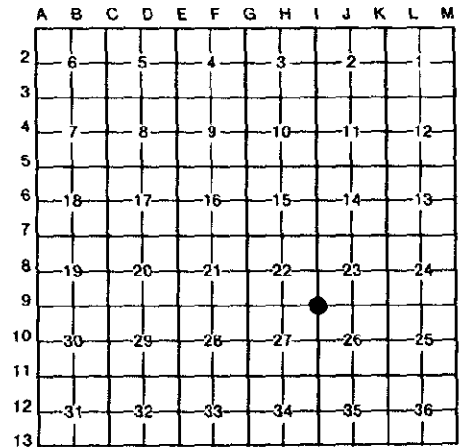

I, William L. Karr, in a field survey on September 28, 1993, do hereby certify that under requirements of P.A. 74, Michigan P.A. of 1970, the corner points mentioned in lines 1 and 2 above were in conformance with regulations and rules therefore as required in the current manual of survey instructions of the United States Department of the Interior, Bureau of Land Management or by a decree of a Court of Law and/or that the corner points mentioned in lines 3, 4 and 5 above were in conformance with the rules of the Michigan Board of Land Surveyors or by a Decree of a Court of Law; established, re-established, monumented, re-monumented, recovered, found as expressed below:

NOTE: Not more than 4 corners, all in the same town and range, may be recorded on this certificate.

A. Description of original monument and accessories and/or subsequent restoration:
(I-9) Section Corner Sections 22, 23, 26 & 27, T45N-R12W

1849: Corner established by Guy H. Carleton
Set post
Birch 9 N 16 W 25 links
Birch 8 S 65 E 15 links

B. Description of corner evidence found and/or method applied in restoring or reestablishing corner:


Corner reestablished as part of the Luce County Remonumentation Program.

Found 2 1/4" O.D. witness corner pipes in the Northeast and Southwest quads, believed to be set by County Surveyor J. Kinsey. Distance between pipes is 90.06'. Reestablished corner position midway and on line between found witness corner pipes. Set a 10" spike in each pipe.

C. Description of monument for corner and accessories established to perpetuate locating the position of the corner:

Corner is a 1/2" x 24" iron with a 3 1/4" diameter stamped aluminum cap, 1" below paved road surface. Falls 4' North of centerline of County Road H-44(98) (East-West, Paved). Falls 1.5' West of centerline of County Road 459 (North-South, gravel to North, paved to South).

2 1/4" O.D. Pipe	N44°E	45.03'
Southwest Foundation Corner of Well House	S60°E	106.83'
16" Maple	S12°E	155.51'
2 1/4" O.D. Pipe	S44°W	45.03'
Anchor Pole	N35°W	56.43'

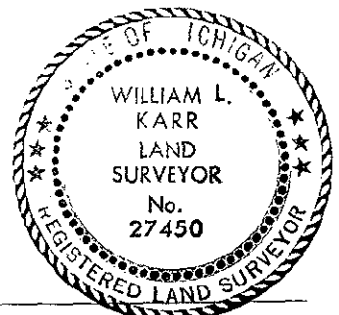

Signed by William L. Karr Date 12/16/93

Surveyor's Michigan License No. 27450

NOTE: Bearings are compass bearings corrected for declination. Distances are to a nail with P.S. 27450 tag in side of witness objects unless noted.