

Luce County Remonumentation Program

1993

LAND CORNER RECORDATION CERTIFICATE
Filing Requirement of Act 74, Mich. P.A. 1970

COMMISSION

For corners in

<u>Luce</u> (County)	Located In:	Corner Code #
1. Public Land Survey	T <u>45N</u> R <u>12W</u>	<u>I-11</u>
	T _____ R _____	_____
	T _____ R _____	_____
	T _____ R _____	_____
2. Property Controlling in Section	S _____ T _____ R _____	_____
	S _____ T _____ R _____	_____
3. Miscellaneous Property in Sec.	S _____ T _____ R _____	_____
	S _____ T _____ R _____	_____

Filed 12-22 A.D., 1993

At 10:00 o'clock A.M.

File No. Lib 9 page 523

Walter S. Mahan
Luce County Reg. of Deeds

Register of Deeds Stamp & File Number

- 4. Lot No. _____, Recorded Plat _____
- 5. Private Claims _____

A	B	C	D	E	F	G	H	I	J	K	L	M
2	5	4	5	4	3	2	1					
3												
4	7	8	9	10	11	12						
5												
6	18	17	16	15	14	13						
7												
8	19	20	21	22	23	24						
9												
10	30	29	28	27	26	25						
11												
12	31	32	33	34	35	36						
13												

I, William L. Karr, in a field survey on September 22, 1993, do hereby certify that under requirements of P.A. 74, Michigan P.A. of 1970, the corner points mentioned in lines 1 and 2 above were in conformance with regulations and rules therefore as required in the current manual of survey instructions of the United States Department of the Interior, Bureau of Land Management or by a decree of a Court of Law and/or that the corner points mentioned in lines 3, 4 and 5 above were in conformance with the rules of the Michigan Board of Land Surveyors or by a Decree of a Court of Law; established, re-established, monumented, re-monumented, recovered, found as expressed below:

NOTE: Not more than 4 corners, all in the same town and range, may be recorded on this certificate.

A. Description of original monument and accessories and/or subsequent restoration:
(I-11) Section Corner Sections 26, 27, 34, & 35, T45N-R12W

1849: Corner established by Guy H. Carleton

1980: Eino Sainio, L.S. 7873

Survey recorded in L.1-P.27 of Surveys notes corner. Survey does not state what it is at corner.

B. Description of corner evidence found and/or method applied in restoring or reestablishing corner:

Corner perpetuated as part of the Luce County Remonumentation Program.


Found a bent 3/4" iron. Falls 1' West of road centerline and on road centerline to the West. Falls on extension of a fence line to the East. Corner position checks with found corners from the survey recorded in L.1-P.27. Accepted corner position as found.

Replaced existing iron with a 1/2" x 24" iron with a 3 1/4" diameter stamped aluminum cap.

C. Description of monument for corner and accessories established to perpetuate locating the position of the corner:

Corner is a 1/2" x 24" iron with a 3 1/4" diameter stamped aluminum cap, 2" below paved road surface. Falls 1' West of centerline of County Road 459 (North-South, paved). Falls on centerline of gravel road to West. Falls on extension of fence line to East.

Power pole	N45°E	48.27'
21" Maple	N86°E	42.18'
Wood Corner Fence Post	East	33.55'
15" Ash	S72°W	135.13'
8" Elm	N16°W	104.01'

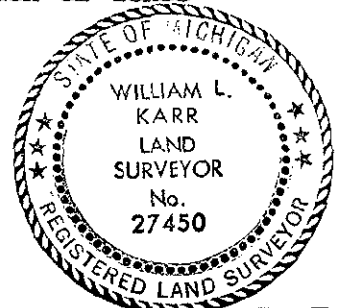

Signed by William L. Karr Date 12/16/93

Surveyor's Michigan License No. 27450

NOTE: Bearings are compass bearings corrected for declination. Distances are to a nail with P.S. 27450 tag in side of witness objects unless noted.