

MAR 18 1999

SECTION

LAND CORNER RECORDATION CERTIFICATE

Filing Requirement of Act 74, Mich. P.A. 1970

Luce County Remonumentation Corner

For corners in

Luce Located In: Corner Code #

1. Public Land Survey T 45N R 12W K-12
 T ___ R ___
 T ___ R ___
 T ___ R ___

2. Property Controlling S ___ T ___ R ___
 in Section S ___ T ___ R ___

3. Miscellaneous S ___ T ___ R ___
 Property in Sec. S ___ T ___ R ___

LUCE COUNTY
 REGISTER OF DEEDS
 Recorded
Liber 3 Page 850
 01-20-1999 15:07:12
Karen Wendt Reg
 Kathy S. Mahar, Register
 REGISTER OF DEEDS

Register of Deeds Stamp & File Number

4. Lot No. _____, Recorded Plat _____
 5. Private Claims _____


I, William L. Karr in a field survey on October 1, 1998, do hereby state that under requirements of P.A. 74, Michigan P.A. of 1970, the corner points mentioned in lines 1 and 2 above were in conformance with regulations and rules therefore as required in the current manual of survey instructions of the United States Department of the Interior, Bureau of Land Management or by a decree of a Court of Law and/or that the corner points mentioned in lines 3, 4 and 5 above were in conformance with the rules of the Michigan Board of Land Surveyors or by a Decree of a Court of Law; established, re-established, monumented, recovered, found as expressed below:

NOTE: Not more than 2 corners, all in the same town and range, may be recorded on this certificate.

A	B	C	D	E	F	G	H	I	J	K	L	M
1												
2	6	5	4	3	2	1						
3												
4	7	8	9	10							12	
5												
6	18	17	16	15	14	13						
7												
8	19	20	21	22	23	24						
9												
10	30	29	28	27	26	25						
11												
12	31	32	33	34	35	36						
13												

T45N R12W

A. Description of original monument and accessories and/or subsequent restoration:
(K-12) 1/4 Corner Common to Sections 35 & 36, Township 45 North, Range 12 West.
 1849: G.H. Carleton, P.S. set post Beech 6" N12°W 6
 Beech 8" S61°E 8

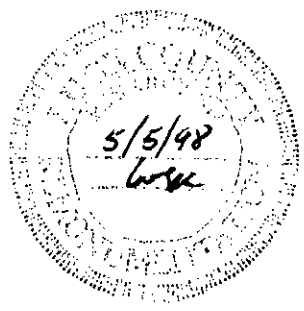

B. Description of corner evidence found and/or method applied in restoring or reestablishing corner:
(K-12) 1/4 Corner Common to Sections 35 & 36, Township 45 North, Range 12 West.
 This corner is being re-established as part of the Luce County Remonumentation Program.
 Found no evidence of the original corner or subsequent restoration. Found a 1/2" iron on the North shore of Manistique Lake and accepted for line. Re-established 1/4 corner 35/36 at the record G.L.O. distance South of Section corner 35 and 36 (2640.00 feet) on this line.

C. Description of monument for corner and accessories established to perpetuate locating the position of the corner:
(K-12) 1/4 Corner Common to Sections 35 & 36, Township 45 North, Range 12 West.
 Corner is a 1/2" x 24" iron with stamped Luce County Remonumentation Corner Cap in Northbound lane of County Road 413.

Witnesses:

Apple	3"	N33°E	33.07 feet
Elm	5"	S30°W	63.82 feet
Twin Elm	4"	S72°W	33.47 feet
Elm	3"	N36°W	48.34 feet



Signed by *William L. Karr* Date 12/22/98

Surveyor's Michigan License No. 27450

NOTE: All bearings are compass bearings corrected for declination. All distances are to a nail and tag in the side of witness object unless otherwise noted.