

LAND CORNER RECORDATION CERTIFICATE

FILING REQUIREMENT OF ACT 74, MICH. P.A. 1970
Luce Co. Four Corners.

| FOR CORNERS OF--: | LOCATED IN--: | CORNER CODE NUMBER |
|--|--|--------------------------|
| 1. PUBLIC LAND SURVEY _____ | T. <u>46</u> ^{N.} S. , R. <u>9</u> ^{E.} W. | A-3 A-5 A-2 A-4 |
| 2. PROPERTY CONTROLLING IN SECTION _____ | T. _____, S. _____, R. _____ | _____ |
| 3. MISCELLANEOUS PROPERTY IN SECTION _____ | T. _____, S. _____, R. _____ | _____ |
| 4. LOT NO. _____, RECORDED PLAT _____ | | |
| 5. PRIVATE CLAIMS _____ | | |


REGISTER OF DEEDS STAMP AND FILING NUMBER _____

I, Billy D. Buckler do hereby certify that under requirements of P.A. 74, Michigan P.A. of 1970 the corner points mentioned in lines 1 and 2 above (identified with circles on index code diagram - over) were, in a field survey on 3-12 1974, established, re-established, monumented, re-monumented, recovered or restored as expressed below and in conformance with regulations and rules therefore as required in the current manual of survey instructions of the United States Department of the Interior, Bureau of Land Management or by a decree of a court of law. Furthermore, that the corner points mentioned in lines 3, 4 and 5 above were, in a field survey on _____ 19____, found, recovered, restored, established or re-established as expressed below and in conformance with the rules of the Michigan State Board of Registration for Land Surveyors or, by a Decree of a Court of law:

- A. Description of original monument and accessories and/or subsequent restoration:
Corners set by John Burt, D.S. 1841, while surveying the Range line.
- A-3 Sec. Cor. 6-7, on West bndry. of twp.
Bearings were: Hemlock 22", S50°W, 49 lks. and Hemlock 13", N31°E, 31 lks.
 - A-2 $\frac{1}{4}$ Corner, on West side, Sec. 6, on West bndry. of twp.
Bearings were: Cedar 7", S30°W, 19 lks. and Cedar 13", N47°E, 12 lks.
 - A-5 Sec. Cor. 7-18, on West bndry. of two.
Bearings were: Spruce 10", Corner Tree and Spruce 10" N63°E
 - A-4 $\frac{1}{4}$ Cor. on West side, Sec. 7, on West Bndry. of Twp.
Bearings were: Birch 10", S39°E, 33 lks. and Fir 9", N20°W, 23 lks.
- B. Description of corner evidence found and/or method applied in restoring or re-establishing corner:
- A-3 Corner re-established by Single Proportionate Measure, on Twp. line bet. corners; 1 mile North and $1\frac{1}{2}$ miles, South.
 - A-2 Corner re-established by Single Proportionate Measure, on Twp. line bet. corners; $\frac{1}{2}$ mile North and 2 miles, South.
 - A-5 Corner re-established by Single Proportionate Measure, on Twp. line bet. corners; $\frac{1}{2}$ mile South and 2 miles North.
 - A-4 Corner re-established by Single Proportionate Measure, on Twp. line bet. corners; 1 mile South and $1\frac{1}{2}$ miles North.
- C. Description of monument for corner and accessories established to perpetuate locating the position of the corner:
Placed 1" pipe with 4" aluminium cap at all corners.
- A-3 New bearings: 8" W. Birch, S85°W, 16.4' and 8" B. Spruce, N42°E, 28.3'
 - A-2 New bearings: 5" Cedar, N57°W, 20.0' and 5" Cedar, S54°E, 2.3'
 - A-5 New bearings: 8" Cedar, N11°W, 46.0' and 8" W. Birch, S22°W, 20.4'
 - A-4 New bearings: 24" W. Pine, N18°W, 27.2' and 14" W. Pine, S4°W, 8.0'

SIGNED BY Billy D. Buckler DATE 3-12-74

SURVEYOR'S MICHIGAN REGISTRATION NO. 8887

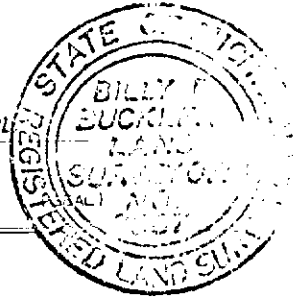

FOR STATE AND UNITED STATES AGENCIES:

SIGNED BY _____ DATE _____
CHIEF OF SURVEY PARTY

APPROVED AND SIGNED BY _____ DATE _____
MICHIGAN REGISTERED LAND SURVEYOR (S.I.A.L.)

SURVEYOR'S MICHIGAN REGISTRATION NO. _____