

SURVEY &
REMONUMENTATION

MAY 28 1997

LUCE COUNTY REMONUMENTATION CORNER

COMMISSION

LAND CORNER RECORDATION CERTIFICATE
Filing Requirement of Act 74, Mich. P.A. 1970

For corners in

Luce _____ (County)	Located in:	Corner Code #
1. Public Land Survey	T46N R 9W	A-2 Same
	T46N R 10W	M-2 Corner
	T _____ R _____	_____
	T _____ R _____	_____
2. Property Controlling in Section	S _____ T _____ R _____	_____
	S _____ T _____ R _____	_____
3. Miscellaneous Property in Sec.	S _____ T _____ R _____	_____
	S _____ T _____ R _____	_____

LUCE COUNTY
REGISTER OF DEEDS

Recorded
Liber 2 Page 716
02-28-1997 08:55:35

Kathy S. Mahar
Kathy S. Mahar, Register
REGISTER OF DEEDS

Register of Deeds Stamp & File Number

4. Lot No. _____, Recorded Plat _____
5. Private Claims _____

I, Keith R. Waters in a field survey on 03/18, 1996 do hereby state that under requirements of P.A. 74, Michigan P.A. of 1970, the corner points mentioned in lines 1 and 2 above were in conformance with regulations and rules therefore as required in the current manual of survey instructions of the United States Department of the Interior, Bureau of Land Management or by a decree of a Court of Law and/or that the corner points mentioned in lines 3, 4 and 5 above were in conformance with the rules of the Michigan Board of Land Surveyors or by a Decree of a Court of Law, established, re-established, monumented, recovered, found as expressed below:

NOTE: Not more than 2 corners, all in the same town and range, may be recorded on this certificate.

1	A	B	C	D	E	F	G	H	I	J	K	L	M
2	6		5		4		3		2		1		
3													
4	7		8		9		10		11		12		
5													
6	18		17		16		15		14		13		
7													
8	19		20		21		22		23		24		
9													
10	30		29		28		27		26		25		
11													
12	31		32		33		34		35		36		
13													

A. Description of original monument and accessories and/or subsequent restoration:

A-2 (M-2) 1/4 Corner Common to Section 6, T46N, R9W & Section 1, T46N, R10W

1841 - Original ties to set post (John Burt): Cedar 7, S30°W 19 links - Cedar 13, N47°E 12 links.

1974 - Billy D. Buckler, RLS 8887, page 142 of Luce County recorded corners. Corner re-established by single proportionate measurement on township line between corners 1/2 mile north and 2 miles south.

Placed a 1" pipe with aluminum cap at corner. Witnesses: 5" Cedar, N57°W 20.0' - 5" Cedar, S54°E 2.3'.

B. Description of corner evidence found and/or method applied in restoring or reestablishing corner:

This corner is being perpetuated as part of the Luce County Remonumentation Program.

Found a 1" pipe with a stamped aluminum DNR cap and both of Buckler's bearings trees. Accepted corner as found and established additional bearing trees.

C. Description of monument for corner and accessories established to perpetuate locating the position of the corner:

Corner is a 1" iron pipe with a stamped aluminum DNR cap.

Witnesses:

8" Cedar, N57°W 20.03' (existing bearing tree)


9" Cedar, S54°E 2.26' (existing bearing tree)

8" Cedar, S48°W 12.22'

10" Cedar, N08°E 20.95'

Note: Distances are to a nail/tag P.S. 33142 in the side of the witness object. Trees are blazed and painted.

Bearings are compass bearings corrected for declination.

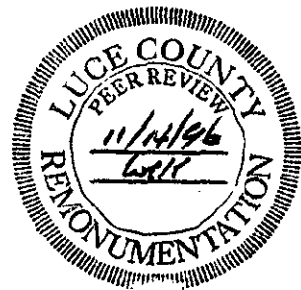

Signed by Keith R. Waters
Surveyor's Michigan License No. 33142

Date 12-30-96