

SURVEY & REMONUMENTATION

APR 28 1995

LUCE COUNTY REMONUMENTATION CORNER

COMMISSION

LAND CORNER RECORDATION CERTIFICATE

Filing Requirement of Act 74, Mich. P.A. 1970

For corners in Luce

(County)

Located In:

Corner Code #

1. Public Land Survey

T 46N R 9W **A-8** Same
T 46N R 10W **M-8** Corner

2. Property Controlling in Section


S T
S T

3. Miscellaneous Property in Sec.

S T
S T

4. Lot No. _____, Recorded Plat

5. Private Claims _____

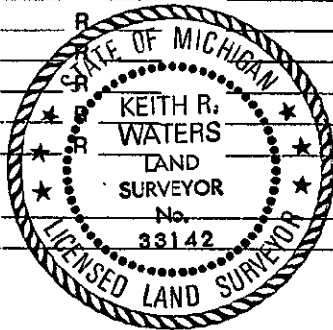

Filed 1/20 A.D., 1995

At 12:30 o'clock P. M.

File No. Liber 2 page 602

Kathy S. Mahan
Luce County Reg. of Deeds

Register of Deeds Stamp & File Number

	A	B	C	D	E	F	G	H	I	J	K	L	M
2	6	5	4	3	2	1							
3													
4	7	8	9	10	11	12							
5													
6	18	17	16	15	14	13							
7													
8	19	20	21	22	23	24							
9													
10	30	29	28	27	26	25							
11													
12	31	32	33	34	35	36							
13													

I, Keith R. Waters, in a field survey on December 3, 1994, do hereby certify that under requirements of P.A. 74, Michigan P.A. of 1970, the corner points mentioned in lines 1 and 2 above were in conformance with regulations and rules therefore as required in the current manual of survey instructions of the United States Department of the Interior, Bureau of Land Management or by a decree of a Court of Law and/or that the corner points mentioned in lines 3, 4 and 5 above were in conformance with the rules of the Michigan Board of Land Surveyors or by a Decree of a Court of Law; established, re-established, monumented, re-monumented, recovered, found as expressed below:

NOTE: Not more than 4 corners, all in the same town and range, may be recorded on this certificate.

A. Description of original monument and accessories and/or subsequent restoration:

M-8 1/4 Corner Common to Section 19, T46N, R9W & Section 24, T46N, R10W

Original ties to post: Beech 10, S60°W 17 links
Hemlock 14, N67°E 34 links

1975 - As recorded on page 265, Luce County corner records, by Billy Buckler, RLS 8887. Replaced found 2" pipe with a 1" pipe and DNR cap. Witnesses: 6" Hard Maple, N40°E 12.8' 6" Red Maple, S42°W 14.5'

B. Description of corner evidence found and/or method applied in restoring or reestablishing corner:

M-8 (T46N, R10W)

This corner is being perpetuated as part of the Luce County Remonumentation Program. Found a 1" pipe with DNR cap and one bearing tree as called for in 1975 records. Accepted corner as found and established additional witness objects.



C. Description of monument for corner and accessories established to perpetuate locating the position of the corner:

M-8 (T46N, R10W)

Corner is a 1" iron pipe with a 4" DNR cap. Witnesses:

- 3" Balsam Fir, N87°E 16.58'
- 8" Sugar Maple, N40°E 12.76'
- 9" Sugar Maple, S47°W 13.27'
- 5" Red Maple, N59°W 14.80'

Note: Distances are to a nail and tag in the side of the tree. Trees are blazed and painted. Bearings are compass bearings corrected for declination.

Signed by Keith R. Waters

Date 12-23-94

Surveyor's Michigan License No. 33142