

**SURVEY & REMONUMENTATION**

LUCE COUNTY REMONUMENTATION CORNER

APR 28 1995

**LAND CORNER RECORDATION CERTIFICATE**

Filing Requirement of Act 74, Mich. P.A. 1970

**COMMISSION**

For corners in Luce (County)

Located In: Corner Code #

- 1. Public Land Survey T 46N R 9W A-11 Same  
T 46N R 10W M-11 Corner
- 2. Property Controlling in Section S \_\_\_\_\_ T \_\_\_\_\_ R \_\_\_\_\_
- 3. Miscellaneous Property in Sec. S \_\_\_\_\_ T \_\_\_\_\_ R \_\_\_\_\_
- 4. Lot No. \_\_\_\_\_, Recorded Plat \_\_\_\_\_
- 5. Private Claims \_\_\_\_\_



Filed 1/20 A.D., 1995

At 12:30 o'clock P. M.

File No. page 603

*Kathy S. Mahan*  
Luce County Reg. of Deeds

Register of Deeds Stamp & File Number

	A	B	C	D	E	F	G	H	I	J	K	L	F
2	6	5	4	3	2	1							
3													
4	7	8	9	10	11	12							
5													
6	18	17	16	15	14	13							
7													
8	19	20	21	22	23	24							
9													
10	30	29	28	27	26	25							
11													
12	31	32	33	34	35	36							
13													

I, Keith R. Waters in a field survey on November 2, 1994, do hereby certify that under requirements of P.A. 74, Michigan P.A. of 1970, the corner points mentioned in lines 1 and 2 above were in conformance with regulations and rules therefore as required in the current manual of survey instructions of the United States Department of the Interior, Bureau of Land Management or by a decree of a Court of Law and/or that the corner points mentioned in lines 3, 4 and 5 above were in conformance with the rules of the Michigan Board of Land Surveyors or by a Decree of a Court of Law; established, re-established, monumented, re-monumented, recovered, found as expressed below:

**NOTE: Not more than 4 corners, all in the same town and range, may be recorded on this certificate.**

A. Description of original monument and accessories and/or subsequent restoration:


M-11 Corner Common to Secs. 30 & 31, T46N, R9W & Secs. 25 & 36, T46N, R10W

Original ties to post: Beech 10, S44°W 47 links Beech 6, N16°E 30 links.  
 1973 - As recorded on page 132 of Luce County corner records, by Peter Chenard, RLS 14200. Set 1/2" bar in road intersection from survey by RLS 7873 (Eino Sainio). Witnesses: P. Pole, S13°E 102.9'  
 P. Pole, N55°E 43.11' P. Pole, N50°W 50.76'  
 1994 - Eino Sainio informed me that this position worked well with a Kinsey offset pipe which has since been removed by road construction.

B. Description of corner evidence found and/or method applied in restoring or reestablishing corner:

M-11 (T46N, R10W)

This corner is being re-established as part of the Luce County Remonumentation Program. 1/2" iron has been removed by road construction. Found all three witness objects as shown in 1973 records. Re-established corner position using said witness objects.

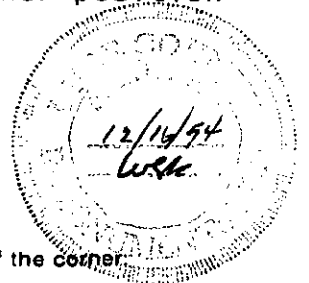

C. Description of monument for corner and accessories established to perpetuate locating the position of the corner:

M-11 (T46N, R10W)

Corner is a 1/2" iron with plastic cap #33142, in intersection of County Roads 461 north-south and 466 east-west. Witnesses:

- Power Pole, N60°W 60.81'
- Power Pole (ML1-30), N50°W 50.76'
- Power Pole, N55°E 43.11'
- Power Pole (W&L-8-L3), S13°E 102.91'

Note: Distance to first pole is to a nail and MDOT tag. Other distances are to a nail and tag #14200. Bearings are compass bearings corrected for declination.

Signed by Keith R. Waters

Date 12-23-94

Surveyor's Michigan License No. 33142