

LUCE COUNTY REMONUMENTATION CORNER

LAND CORNER RECORDATION CERTIFICATE
Filing Requirement of Act 74, Mich. P.A. 1970

For corners in

Luce _____ (County)	Located In:	Corner Code #
1. Public Land Survey	T46N R 9W	B-11
	T _____ R _____	_____
	T _____ R _____	_____
	T _____ R _____	_____
2. Property Controlling in Section	S _____ T _____ R _____	_____
	S _____ T _____ R _____	_____
3. Miscellaneous Property in Sec.	S _____ T _____ R _____	_____
	S _____ T _____ R _____	_____

LUCE COUNTY
REGISTER OF DEEDS
Recorded

02-29-1996 15:16:41
Liber 2 page 643
Kathy S. Mahar, Register
REGISTER OF DEEDS
Kathy S. Mahar
Register of Deeds Stamp & File Number

4. Lot No. _____, Recorded Plat _____
5. Private Claims _____

I, Keith R. Waters, in a field survey on 11/11, 1995 do hereby state that under requirements of P.A. 74, Michigan P.A. of 1970, the corner points mentioned in lines 1 and 2 above were in conformance with regulations and rules therefore as required in the current manual of survey instructions of the United States Department of the Interior, Bureau of Land Management or by a decree of a Court of Law and /or that the corner points mentioned in lines 3, 4 and 5 above were in conformance with the rules of the Michigan Board of Land Surveyors or by a Decree of a Court of Law; established, re-established, monumented, recovered, found as expressed below:

NOTE: Not more than 2 corners, all in the same town and range, may be recorded on this certificate.

A	B	C	D	E	F	G	H	I	J	K	L	M
1												
2	6		5		4		3		2		1	
3												
4	7		8		9		10		11		12	
5												
6	10		17		16		15		14		13	
7												
8	19		20		21		22		23		24	
9												
10	30		29		28		27		26		25	
11	●											
12	31		32		33		34		35		36	
13												

A. Description of original monument and accessories and/or subsequent restoration:

B-11 1/4 Corner Common to Sections 30 & 31, Town 46 North, Range 9 West
1850 - Original ties to set post: Cedar 6, N76°E 11 links - Cedar 12, S73°W 36 links.

1983 - Neil E. Hill, P.S. 27447, Michigan Department of State Highways and Transportation, found a 1 1/2" rusted pipe in line with fence line north and brushed line to south. Witnesses: Twin 6" Cedars, S10°W 53.97' - 9" Cedar, SOUTH 55.98' - Bolt in Road, EAST 69.50' - 7" Cedar, S15°E 55.00' - 4" White Birch, N40°W 32.38'


B. Description of corner evidence found and/or method applied in restoring or reestablishing corner:

This corner is being perpetuated as part of the Luce County Remonumentation Program.
Found a 2" O.D. iron pipe in the approximate centerline of east-west gravel road. Also found two of the bearing trees as called for in 1983 Highway Department records. The distance west to recorded Section corner A-11 checks with Highway Department records and is within 1.3 feet of original GLO distance. Accepted corner location as found and set a 1/2" rebar with a 3" aluminum Luce County Remonumentation cap inside found pipe.

C. Description of monument for corner and accessories established to perpetuate locating the position of the corner:

Corner is a 1/2" rebar with a 3" aluminum Luce County Remonumentation cap in a found 2" iron pipe, in the approximate centerline of east-west gravel road (County Road 466). Witnesses:
6" Cedar, S37°W 74.04' (Nail/tag P.S. 33142 in side)
10" Cedar, S07°W 53.73' (Highway Department nail/tag in side)
11" Cedar, S04°E 55.76' (Nail/tag P.S. 33142 over found Highway Department nail/tag in side)
8" Cedar, S27°E 70.47' (Nail/tag P.S. 33142 in side)

Note: Trees are blazed and painted.
Bearings are compass bearings corrected for declination.

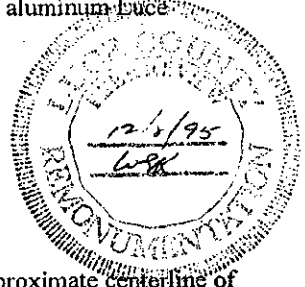

Signed by Keith R. Waters
Surveyor's Michigan License No. 33142

Date 12-29-95