

LUCE COUNTY REMONUMENTATION CORNER

LAND CORNER RECORDATION CERTIFICATE Filing Requirement of Act 74, Mich. P.A. 1970

For corners in

Luce

(County)

Located In:

Corner Code #

1. Public Land Survey		T46N R 9W	C-9
		T _____ R _____	_____
		T _____ R _____	_____
		T _____ R _____	_____
2. Property Controlling in Section	S _____	T _____ R _____	_____
	S _____	T _____ R _____	_____
3. Miscellaneous Property in Sec.	S _____	T _____ R _____	_____
	S _____	T _____ R _____	_____

LUCE COUNTY
REGISTER OF DEEDS
Recorded

02-29-1996 15:22:14
Liber 2 Page 656
Kathy S. Mahaf, Register
REGISTER OF DEEDS
Kathy S. Mahaf

Register of Deeds Stamp & File Number

4. Lot No. _____, Recorded Plat _____
5. Private Claims _____

I, Keith R. Waters in a field survey on 08/31, 1995 do hereby state that under requirements of P.A. 74, Michigan P.A. of 1970, the corner points mentioned in lines 1 and 2 above were in conformance with regulations and rules therefore as required in the current manual of survey instructions of the United States Department of the Interior, Bureau of Land Management or by a decree of a Court of Law and/or that the corner points mentioned in lines 3, 4 and 5 above were in conformance with the rules of the Michigan Board of Land Surveyors or by a Decree of a Court of Law; established, re-established, monumented, recovered, found as expressed below:

NOTE: Not more than 2 corners, all in the same town and range, may be recorded on this certificate.

1	A	B	C	D	E	F	G	H	I	J	K	L	M
2	6		5		4		3		2		1		
3													
4	7		8		9		10		11		12		
5													
6	18		17		16		15		14		13		
7													
8	19		20		21		22		23		24		
9													
10	30		29		28		27		26		25		
11													
12	31		32		33		34		35		36		
13													

A. Description of original monument and accessories and/or subsequent restoration:

C-9 Corner Common to Sections 19, 20, 29, & 30, Town 46 North, Range 9 West
1850 - Original ties to set post: Hemlock 18, S57°W 21 links - Hemlock 20, N35°E 20 links.

1975 - Billy D. Buckler, R.L.S. 8887, Luce County recorded corners, page 271. Recorded corner as placed by H. Lawrence. Found a 2" iron pipe 33.0' south and 33.0' east of corner. Pipe is 2' south of fence line. Road has been raised 4' to 8' above original ground. Placed a 5/8" iron rod 13.0' south of corner position, 9.0' south of blacktop. Section corner is in blacktop, 4.0' north of south edge. Corner is 45.5' west of a gate on the south side of the road.

B. Description of corner evidence found and/or method applied in restoring or reestablishing corner:


This corner is being perpetuated as part of the Luce County Remonumentation Program.
Found the 5/8" iron rod and the 2" iron pipe as called for in 1975 LCRC. Placed corner 13.0 feet north of the found 5/8" rod, on a line projected from the Section corner C-11 through a point 33.00 feet west of the found 2" pipe.



C. Description of monument for corner and accessories established to perpetuate locating the position of the corner:

Corner is a 1/2" iron with a plastic cap #33142, approximately 7 feet south of the centerline of east-west asphalt road (County Road 462). Witnesses:
5/8" Iron Rod, SOUTH 13.00'
2" Iron Pipe, S44°E 46.87'
11" White Birch, S41°E 68.89'
11" Balsam Fir, S20°E 40.14'
8" Balsam Fir, SOUTH 47.06'
9" White Birch, S30°W 54.76'

Note: Trees are blazed and painted. Bearings are compass bearings corrected for declination.
Distance to trees is to a nail/tag P.S. 33142 in the side.

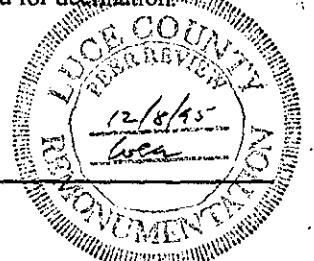

Signed by Keith R. Waters
Surveyor's Michigan License No. 33142

Date 12-29-95