

LUCE COUNTY REMONUMENTATION CORNER

LAND CORNER RECORDATION CERTIFICATE Filing Requirement of Act 74, Mich. P.A. 1970

For corners in

Luce _____ (County)	Located In:	Corner Code #	
1. Public Land Survey	T <u>46N</u> R <u>9W</u>	<u>E-9</u>	
	T _____ R _____	_____	
	T _____ R _____	_____	
	T _____ R _____	_____	
2. Property Controlling in Section	S _____ T _____ R _____	_____	
	S _____ T _____ R _____	_____	
3. Miscellaneous Property in Sec.	S _____ T _____ R _____	_____	
	S _____ T _____ R _____	_____	

LUCE COUNTY
REGISTER OF DEEDS
Recorded

Liber 2 page 658
02-29-1996 15:22:33

Kathy S. Mahar, Register
REGISTER OF DEEDS

Kathy S. Mahar

Register of Deeds Stamp & File Number

4. Lot No. _____, Recorded Plat _____
5. Private Claims _____

I, Keith R. Waters, in a field survey on 08/31, 1995 do hereby state that under requirements of P.A. 74, Michigan P.A. of 1970, the corner points mentioned in lines 1 and 2 above were in conformance with regulations and rules therefore as required in the current manual of survey instructions of the United States Department of the Interior, Bureau of Land Management or by a decree of a Court of Law and for that the corner points mentioned in lines 3, 4 and 5 above were in conformance with the rules of the Michigan Board of Land Surveyors or by a Decree of a Court of Law, established, re-established, monumented, recovered, found as expressed below.

NOTE: Not more than 2 corners, all in the same town and range, may be recorded on this certificate.

	A	B	C	D	E	F	G	H	I	J	K	L	M
1													
2	6		5		4		3		2		1		
3													
4	7		8		9		10		11		12		
5													
6	18		17		16		15		14		13		
7													
8	19		20		21		22		23		24		
9					●								
10	30		29		28		27		26		25		
11													
12	31		32		33		34		35		36		
13													


A. Description of original monument and accessories and/or subsequent restoration:

E-9 Corner Common to Sections 20, 21, 28, & 29, Town 46 North, Range 9 West
1850 - Original ties to set post: Spruce 12, N28°W 30 links - Spruce 8, S58°E 13 links.

1974 - Billy D. Buckler, R.L.S. 8887, Luce County recorded corners, page 267. Replaced corner at squared wood post set by H. Lawrence, R.L.S. Location checks with other corners in the area. Placed a 1" pipe with 4" aluminum cap.
Witnesses: 6" Spruce, S12°W 17.1' - 10" Spruce, N20°W 9.2'

B. Description of corner evidence found and/or method applied in restoring or reestablishing corner:

This corner is being perpetuated as part of the Luce County Remonumentation Program.
Found a 1" pipe with an aluminum DNR cap as called for in 1974 LCRC. Both record bearing trees are alive and standing.
Accepted corner as found and established additional witness objects.

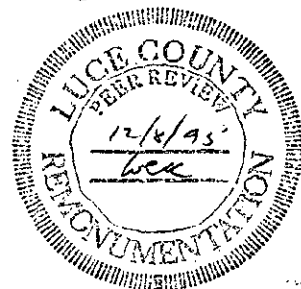

C. Description of monument for corner and accessories established to perpetuate locating the position of the corner:

Corner is a 1" iron pipe with a 4" aluminum DNR cap approximately 43 feet south of the centerline of an east-west gravel road (County Road 462). Witnesses:
8" Spruce, S08°W 17.21'
10" Balsam Fir, S59°W 19.74'
8" Spruce, N83°W 15.45'
12" Spruce, N17°W 9.66'

Note: Distances are to a nail/tag P.S. 33142 in the side of the tree. Trees are blazed and painted.
Bearings are compass bearings corrected for declination.



Signed by Keith R. Waters
Surveyor's Michigan License No. 33142

Date 12-29-95