

LUCE COUNTY REMONUMENTATION CORNER

LAND CORNER RECORDATION CERTIFICATE
Filing Requirement of Act 74, Mich. P.A. 1970

For corners in


Luce	Located in:	Corner Code #
(County)		
1. Public Land Survey	T46N R9W	F-9
	T___ R___	_____
	T___ R___	_____
	T___ R___	_____
2. Property Controlling in Section	S___ T___ R___	_____
	S___ T___ R___	_____
3. Miscellaneous Property in Sec.	S___ T___ R___	_____
	S___ T___ R___	_____

LUCE COUNTY
REGISTER OF DEEDS
Recorded
Lib 2 Page 059
02-29-1996 15:22:41
Kathy S. Mahar
Kathy S. Mahar, Register
REGISTER OF DEEDS
Register of Deeds Stamp & File Number

4. Lot No. _____, Recorded Plat _____
5. Private Claims _____

I, Keith R. Waters, in a field survey on 08/31, 1995 do hereby state that under requirements of P.A. 74, Michigan P.A. of 1970, the corner points mentioned in lines 1 and 2 above were in conformance with regulations and rules therefore as required in the current manual of survey instructions of the United States Department of the Interior, Bureau of Land Management or by a decree of a Court of Law and /or that the corner points mentioned in lines 3, 4 and 5 above were in conformance with the rules of the Michigan Board of Land Surveyors or by a Decree of a Court of Law; established, re-established, monumented, recovered, found as expressed below:

NOTE: Not more than 2 corners, all in the same town and range, may be recorded on this certificate.

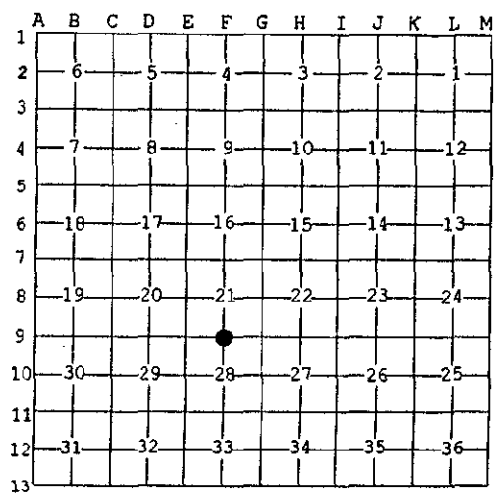

A. Description of original monument and accessories and/or subsequent restoration:

F-9 1/4 Corner Common to Sections 21 & 28, Town 46 North, Range 9 West
1850 - Original ties to set post: Spruce 10, N43°W 21 links - Cedar 10, S70°E 22 links.

1974 - Billy D. Buckler, R.L.S. 8887, Luce County recorded corners, page 267. Replaced corner at wood post set by H. Lawrence, R.L.S.
Location checks with other corners in the area.
Witnesses: 12" Cedar, N84°W 41.8' - 6" Cedar, S23°W 43.7'

B. Description of corner evidence found and/or method applied in restoring or reestablishing corner:

This corner is being perpetuated as part of the Luce County Remonumentation Program.
Found a 1" pipe with an aluminum DNR cap as called for in 1974 LCRC. Both record bearing trees are alive and standing.
Accepted corner as found and established additional witness objects.

C. Description of monument for corner and accessories established to perpetuate locating the position of the corner:

Corner is a 1" iron pipe with a 4" aluminum DNR cap.
Witnesses:
14" Cedar, N88°W 41.99'
8" Cedar, S22°W 44.10'
14" Red Maple, N11°E 27.38'
9" Ash, S67°W 15.25'

Note: Distances are to a nail/tag P.S. 33142 in the side of the tree. Trees are blazed and painted.
Bearings are compass bearings corrected for declination.

Signed by Keith R. Waters
Surveyor's Michigan License No. 33142

Date 12-29-95

