LUCE COUNTY REMONUMENTATION CORNER

LAND CORNER RECORDATION CERTIFICATE
Filing Requirement of Act 74, Mich. P.A. 1970

For corners in

Luce
(County)

	Located In:	Corner Code #
1. Public Land Survey	T46N R 9W	G-11
	T___ R___	
	T___ R___	
	T___ R___	
2. Property Controlling	S___ T___ R___	
in Section	S___ T___ R___	
3. Miscellaneous	S___ T___ R___	
Property in Sec.	S___ T___ R___	

LUCE COUNTY
REGISTER OF DEEDS
Recorded Kathy S. Mahar
02-29-1996 15:17:57
Liber 2 Page 648
Kathy S. Mahar, Register
REGISTER OF DEEDS
Register of Deeds Stamp & File Number

4. Lot No. _____, Recorded Plat _____
5. Private Claims _____

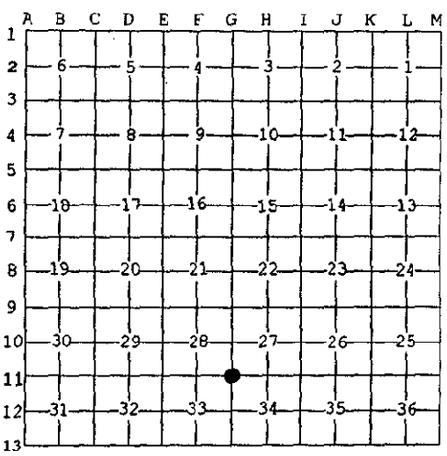

I, Keith R. Waters, in a field survey on 11/07, 19 95 do hereby state that under requirements of P.A. 74, Michigan P.A. of 1970, the corner points mentioned in lines 1 and 2 above were in conformance with regulations and rules therefore as required in the current manual of survey instructions of the United States Department of the Interior, Bureau of Land Management or by a decree of a Court of Law and /or that the corner points mentioned in lines 3, 4 and 5 above were in conformance with the rules of the Michigan Board of Land Surveyors or by a Decree of a Court of Law; established, re-established, monumented, recovered, found as expressed below:

NOTE: Not more than 2 corners, all in the same town and range, may be recorded on this certificate.

A. Description of original monument and accessories and/or subsequent restoration:

G-11 Corner Common to Sections 27, 28, 33, & 34, Town 46 North, Range 9 West
1850 - Original ties to set post: Spruce 10, S55°W 09 links - Spruce 10, N49°E 18 links.

1989 - Eino Sainio, P.S. 7873, Certificate of Survey recorded in liber 1 of Surveys, page 106, Luce County records. Corner is shown at a distance of 15809.0 feet east of Section corner A-11.

B. Description of corner evidence found and/or method applied in restoring or reestablishing corner:

This corner is being perpetuated as part of the Luce County Remonumentation Program.
Found a 3" x 1 1/2" elliptical iron bar at the approximate centerline P.I. of gravel roads to the west and south (County Road 466).
The distance west to recorded Section corner A-11 checks well with that as shown in above mentioned Certificate of Survey.
Accepted corner as found.

LUCE COUNTY PEER REVIEW 12/8/95 WRL REMONUMENTATION

C. Description of monument for corner and accessories established to perpetuate locating the position of the corner:

Corner is a 3" x 1 1/2" elliptical iron bar at the approximate centerline P.I. of County Road 466 to the west and south (gravel).
Witnesses:
6" Aspen, S09°E 191.72'
8" Aspen, S12°W 145.21'
5" White Birch, S58°W 95.32'
3" Balsam Fir, S20°E 80.94'

Note: Distances are to a nail/tag P.S. 33142 in the side of the tree. Trees are blazed and painted.
Bearings are compass bearings corrected for declination.

STATE OF MICHIGAN KEITH R. WATERS LAND SURVEYOR No. 33142 LICENSED LAND SURVEYOR

Signed by Keith R. Waters Date 12-29-95
Surveyor's Michigan License No. 33142

FORM APPROVED BY MICHIGAN STATE BOARD OF PROFESSIONAL SURVEYORS, JAN. 28, 1971
REVISED MAY 14,1975
REVISED JAN., 1983
REVISED OCT., 1995