


LAND CORNER RECORDATION CERTIFICATE
Filing Requirement of Act 74, Mich. P.A. 1970

For corners in

Luce		Located In:	Corner Code #
_____	(County)		
1. Public Land Survey	T 46N R 9W		K3
	T _____ R _____		_____
	T _____ R _____		_____
	T _____ R _____		_____
2. Property Controlling in Section	S _____ T _____ R _____		_____
	S _____ T _____ R _____		_____
3. Miscellaneous Property in Sec.	S _____ T _____ R _____		_____
	S _____ T _____ R _____		_____

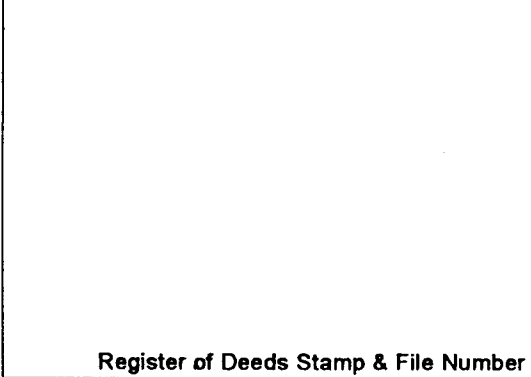

4. Lot No. _____, Recorded Plat _____
 5. Private Claims _____

Mar 23 2005

I, Stephan J. Szyszkoski, in a field survey on _____, 19____ do hereby state that under requirements of P.A. 74, Michigan P.A. of 1970, the corner points mentioned in lines 1 and 2 above were in conformance with regulations and rules therefore as required in the current manual of survey instructions of the United States Department of the Interior, Bureau of Land Management or by a decree of a Court of Law and /or that the corner points mentioned in lines 3, 4 and 5 above were in conformance with the rules of the Michigan Board of Land Surveyors or by a Decree of a Court of Law; established, re-established, monumented, recovered, found as expressed below:

NOTE: Not more than 2 corners, all in the same town and range, may be recorded on this certificate.

A	B	C	D	E	F	G	H	I	J	K	L	M
1												
2	6		5		4		3		2		1	
3										●		
4	7		8		9		10		11		12	
5												
6	10		17		16		15		14		13	
7												
8	19		20		21		22		23		24	
9												
10	30		29		28		27		26		25	
11												
12	31		32		33		34		35		36	
13												


A. Description of original monument and accessories and/or subsequent restoration:
 (K3) Corner common to Sections 1-2-11-12. 1850 - Established by Harvey Mellen, Deputy Surveyor: Corrected West between Sections 1 & 12 ...80.34 Set post corner of Sections 1-2-11-12 in windfall. Tamarac 6 S36E 19 links, Tamarac 6 S29W 31 links.

B. Description of corner evidence found and/or method applied in restoring or reestablishing corner:

(K3) The original post and accessories were not recovered. Found no evidence of subsequent perpetuation of the corner. Reestablished the corner by double proportionated measurement to the original record between monumented corners 80.02 ch. North (5271.14' M), 80.34 ch. East (5235.99' M), 79.94 ch. South (5265.14' M), and 40.17 ch. West (2618.38' M).

C. Description of monument for corner and accessories established to perpetuate locating the position of the corner:

(K3) Set 1" IDx36" I.pipe with 4" alum. MDNR cap. Set measuring nails in:
 12" B.Spruce S08W 54.2' mrkd "S11 NBT"
 12" W.Birch S61W 19.15' do
 5" Balsam N70E 35.4' "S1 NBT"
 4" Balsam N54W 14.1' "S2 NBT"
 Bearings are magnetic. Distances are to nail with tag.

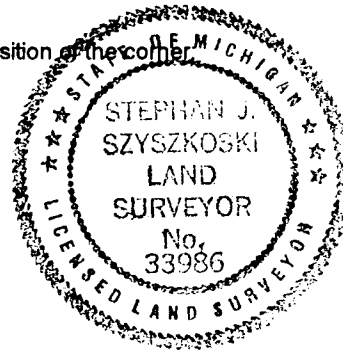

Signed by Stephan J. Szyszkoski
 Surveyor's Michigan License No. 33986

Date 6/22/05