

LAND CORNER RECORDATION CERTIFICATE
Filing Requirement of Act 74, Mich. P.A. 1970

For corners in

Luce	Located In:	Corner Code #	
(County)			
1. Public Land Survey	T 46N R 9W	K4	
	T R		
	T R		
	T R		
2. Property Controlling in Section	S T R		
	S T R		
3. Miscellaneous Property in Sec.	S T R		
	S T R		

Register of Deeds Stamp & File Number

4. Lot No. _____, Recorded Plat _____
 5. Private Claims _____

Mar 24 2005

I, Stephan J. Szyszkoski, in a field survey on _____, 19____ do hereby state that under requirements of P.A. 74, Michigan P.A. of 1970, the corner points mentioned in lines 1 and 2 above were in conformance with regulations and rules therefore as required in the current manual of survey instructions of the United States Department of the Interior, Bureau of Land Management or by a decree of a Court of Law and/or that the corner points mentioned in lines 3, 4 and 5 above were in conformance with the rules of the Michigan Board of Land Surveyors or by a Decree of a Court of Law; established, re-established, monumented, recovered, found as expressed below:

NOTE: Not more than 2 corners, all in the same town and range, may be recorded on this certificate.

	A	B	C	D	E	F	G	H	I	J	K	L	M
1													
2		6		5		4		3		2		1	
3													
4		7		8		9		10		11	●	12	
5													
6		18		17		16		15		14		13	
7													
8		19		20		21		22		23		24	
9													
10		30		29		28		27		26		25	
11													
12		31		32		33		34		35		36	
13													


A. Description of original monument and accessories and/or subsequent restoration:
 (K4) Quarter corner common to Sections 11-12. 1850 - Established by Harvey Mellen, Deputy Surveyor: N18'W Corrected between Sections 11 & 12 ...39.97 Set post Qr. Sect. corner. Tamarac 9 S73W 14 links, Tamarac 8 N52E 14 links. ... 79.94 Section corner.

B. Description of corner evidence found and/or method applied in restoring or reestablishing corner:

(K4) The original post and accessories were not recovered. Found no evidence of subsequent perpetuation. Reestablished the corner by single proportionate measurement to the original record between monumented corners K3 and K5.

C. Description of monument for corner and accessories established to perpetuate locating the position of the corner:

(K4) Set 1"IDx36" I.pipe with 4" alum. MDNR cap. Set measuring nails in:
 10" Cedar N08E 17.25' mrkd "1/4S NBT"
 12" Tamarack S80E 25.55' do
 10" W.Birch S05E 5.1' do
 8" W.Birch S40E 30.35' do
 Bearings are magnetic. Distances are to nail with tag.

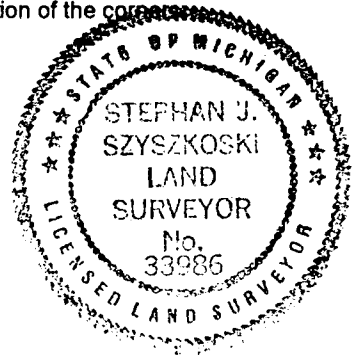

Signed by Stephan J. Szyszkoski
 Surveyor's Michigan License No. 33986

Date 6/22/05