

LAND CORNER RECORDATION CERTIFICATE
Filing Requirement of Act 74, Mich. P.A. 1970

For corners in

Luce

(County)

Located In:

Corner Code #

1. Public Land Survey	T <u>46N</u> R <u>9W</u>	<u>M3</u>
	T _____ R _____	_____
	T _____ R _____	_____
	T _____ R _____	_____
2. Property Controlling in Section	S _____ T _____ R _____	_____
	S _____ T _____ R _____	_____
3. Miscellaneous Property in Sec.	S _____ T _____ R _____	_____
	S _____ T _____ R _____	_____

Register of Deeds Stamp & File Number

4. Lot No. _____, Recorded Plat _____
 5. Private Claims _____

Mar 21 2005

I, Stephan J. Szyszkoski, in a field survey on _____, 19____ do hereby state that under requirements of P.A. 74, Michigan P.A. of 1970, the corner points mentioned in lines 1 and 2 above were in conformance with regulations and rules therefore as required in the current manual of survey instructions of the United States Department of the Interior, Bureau of Land Management or by a decree of a Court of Law and /or that the corner points mentioned in lines 3, 4 and 5 above were in conformance with the rules of the Michigan Board of Land Surveyors or by a Decree of a Court of Law; established, re-established, monumented, recovered, found as expressed below:

NOTE: Not more than 2 corners, all in the same town and range, may be recorded on this certificate.

A	B	C	D	E	F	G	H	I	J	K	L	M
1												
2	6		5		4		3		2		1	
3												
4	7		8		9		10		11		12	
5												
6	18		17		16		15		14		13	
7												
8	19		20		21		22		23		24	
9												
10	30		29		28		27		26		25	
11												
12	31		32		33		34		35		36	
13												

A. Description of original monument and accessories and/or subsequent restoration:


(M3) Corner common to Sections 1-12 T46N-R09W and Sections 6-7 T46N-R08W. 1840 - Established by Wm. Burt, Deputy Surveyor: North on East side Section 12 ... 80.00 Set post corner of Sections 1 & 12. Cedar 6 S10W 33, Hemlock 14 N11W 39. 1850 - Additional BTs by Wells Burt: Hemlock 18 N32E 25, Hemlock 9 S72E 24. 1969 - Remonumented by Billy D. Buckler RLS: Corner replaced from Hemlock witness, a stub, N32E 25 links. Upper face in excellent condition with most scribe marks plain. Set 1" pipe with 4" aluminum cap. 10" Cedar N20E 32.2', -12" Hemlock S85E 21.6'.

B. Description of corner evidence found and/or method applied in restoring or reestablishing corner:

(M3) Found the 1969 monument in good condition and at record bearing and distance from the 1969 NBTs, both in good condition. Accepted the corner as a careful and faithful perpetuation of the position of the original corner and made new witnesses, as described below.

C. Description of monument for corner and accessories established to perpetuate locating the position of the corner:

(M3) Found 1" ID 1. pipe with 4" alum. MDNR cap. Set measuring nails in:
 12" Cedar N21E 32.6' * mrkd "S6"
 14" Hemlock S82E 22.55' * mrkd "S7"
 4" W. Birch S27E 6.7' mrkd "S7 NBT"
 9" Maple S35W 29.45' "S12 NBT"
 Bearings are magnetic. Distances are to nail with tag. * denotes 1972 NBT.

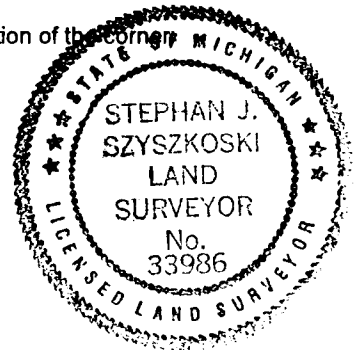

Signed by Stephan J. Szyszkoski
 Surveyor's Michigan License No. 33986

Date 6/22/05