

LAND CORNER RECORDATION CERTIFICATE
Filing Requirement of Act 74, Mich. P.A. 1970

For corners in

Luce

(County)

Located In:

Corner Code #

- | | | | | | |
|------------------------------------|---|-----|---|----|----|
| 1. Public Land Survey | T | 46N | R | 9W | M6 |
| | T | | R | | |
| | T | | R | | |
| | T | | R | | |
| 2. Property Controlling in Section | S | | T | R | |
| | S | | T | R | |
| 3. Miscellaneous Property in Sec. | S | | T | R | |
| | S | | T | R | |

Register of Deeds Stamp & File Number

4. Lot No. _____, Recorded Plat _____
 5. Private Claims _____

Mar 21 2005

I, Stephan J. Szyszkoski, in a field survey on _____, 19____ do hereby state that under requirements of P.A. 74, Michigan P.A. of 1970, the corner points mentioned in lines 1 and 2 above were in conformance with regulations and rules therefore as required in the current manual of survey instructions of the United States Department of the Interior, Bureau of Land Management or by a decree of a Court of Law and /or that the corner points mentioned in lines 3, 4 and 5 above were in conformance with the rules of the Michigan Board of Land Surveyors or by a Decree of a Court of Law; established, re-established, monumented, recovered, found as expressed below:

NOTE: Not more than 2 corners, all in the same town and range, may be recorded on this certificate.

	A	B	C	D	E	F	G	H	I	J	K	L	M
1													
2		6		5		4		3		2		1	
3													
4		7		8		9		10		11		12	
5													
6		18		17		16		15		14		13	
7													
8		19		20		21		22		23		24	
9													
10		30		29		28		27		26		25	
11													
12		31		32		33		34		35		36	
13													


A. Description of original monument and accessories and/or subsequent restoration:
 (M6) Quarter corner common to Section 13 T46N-R9W and Section 18 T46N-R8W. 1840 - Established by Wm. Burt: North on East side of Section 13 ... 40.00 Spruce 4 qr. Sect. Cor. Y.Pine 24 S85W 5 links ... 80.00 Set post corner of sections 12 & 13. 1967 - Original Y.Pine BT recovered by Wm. Botti, forester for Michigan Dept. of Natural Resources. 1969 - Remonumented by Billy D. Buckler RLS: Corner replaced from original witness, found bottom face, notch and scribe marks. Set 1" pipe with 4" aluminum cap at corner. 13" R.Pine S81W 17.7', 12" R.Pine N34E 13.7'.

B. Description of corner evidence found and/or method applied in restoring or reestablishing corner:

(M6) Found the 1969 monument in good condition and at record bearing and distance from the 1969 NBTs, both in good condition with scribing partially visible, and at record bearing and distance from the original Y.Pine BT, a stump with scribing legible. Accepted the monument as a careful and faithful perpetuation of the position of the original corner.

C. Description of monument for corner and accessories established to perpetuate locating the position of the corner:

(M6) Found 1" ID I.pipe with 4" alum. MDNR cap. Set measuring nails in:
 16" R.Pine S82W 18.3' old marks *
 16" R.Pine N35E 13.95' do *
 12" R.Pine N24W 8.8' mrkd "1/4S NBT"
 14" R.Pine S06E 29.9' do
 Bearings are magnetic. Distances are to nail with tag. * denotes 1969 NBT.

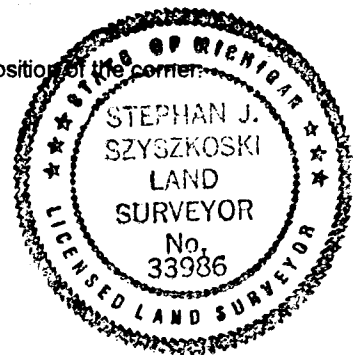

Signed by Stephan J. Szyszkoski
 Surveyor's Michigan License No. 33986

Date 6/22/05