LAND CORNER RECORDATION CERTIFICATE
Filing Requirement of Act 74, Mich. P.A. 1970

For corners in

Luce
(County)

	Located In:			Corner Code #
1. Public Land Survey		T___	R___	_____
		T___	R___	_____
		T___	R___	_____
		T___	R___	_____
2. Property Controlling	S 11	T 46N	R 9W	7
in Section	S 11	T 46N	R 9W	3
3. Miscellaneous	S___	T___	R___	_____
Property in Sec.	S___	T___	R___	_____

Register of Deeds Stamp & File Number

4. Lot No. _____ , Recorded Plat _____
5. Private Claims _____

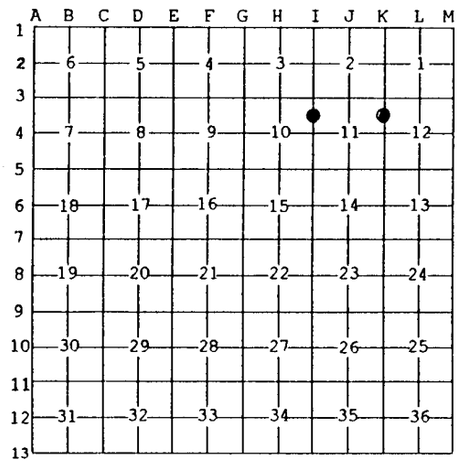

Mar 23 2005

I, Stephan J. Szyszkoski, in a field survey on _____, 19 ___ do hereby state that under requirements of P.A. 74, Michigan P.A. of 1970, the corner points mentioned in lines 1 and 2 above were in conformance with regulations and rules therefore as required in the current manual of survey instructions of the United States Department of the Interior, Bureau of Land Management or by a decree of a Court of Law and /or that the corner points mentioned in lines 3, 4 and 5 above were in conformance with the rules of the Michigan Board of Land Surveyors or by a Decree of a Court of Law; established, re-established, monumented, recovered, found as expressed below:

NOTE: Not more than 2 corners, all in the same town and range, may be recorded on this certificate.

A. Description of original monument and accessories and/or subsequent restoration:

(7-Sec. 11) North 1/16 corner between Sections 11-12. Not established in the original survey.
(3-Sec. 11) North 1/16 corner between Sections 10 and 11. Not established in the original survey.

B. Description of corner evidence found and/or method applied in restoring or reestablishing corner:

(7-Sec. 11) Established the corner midway and on line between Section corner 1316.28' North and Quarter corner 1316.28' South.
(3-Sec. 11) Established the corner midway and on line between Section corner 1320.46' North and Quarter corner 1320.46' South.

C. Description of monument for corner and accessories established to perpetuate locating the position of the corner:

(7) Set 1"IDx36" I.pipe with 4" alum. MDNR cap. Set measuring nails in:
5" B.Spruce S43E 5.7' mrkd "N1/16 BT"
3" B.Spruce N30W 4.35' do
3" B.Spruce N72W 8.7' do
4" B.Spruce S45W 32.95' do
Bearings are magnetic. Distances are to nail with tag.

(3) Set 1"IDx36" I.pipe with 4" alum. MDNR cap. Set measuring nails in:
5" Balsam S52W 107.78' mrkd "N1/16 BT"
28" Tamarack S28W 345.9' do
14" Spruce N79E 174.66' do
16" Cedar N19E 159.87' do
Bearings are magnetic. Distances are to nail with tag.

STATE OF MICHIGAN
STEPHAN J. SZYSZKOSKI
LAND SURVEYOR
No. 33986
LICENSED LAND SURVEYOR

Signed by Stephen J. Szyszkoski Date 6/22/05
Surveyor's Michigan License No. 33986

For the Michigan Department of Natural Resources - Office of Land and Facilities

FORM APPROVED BY MICHIGAN STATE BOARD OF PROFESSIONAL SURVEYORS, JAN. 26, 1971
REVISED MAY 14,1975
REVISED JAN., 1983
REVISED OCT., 1995