

MAY 28 1997

LUCE COUNTY REMONUMENTATION CORNER

COMMISSION

LAND CORNER RECORDATION CERTIFICATE  
Filing Requirement of Act 74, Mich. P.A. 1970

LUCE COUNTY  
REGISTER OF DEEDS

Recorded  
*Liber 2 Page 705*  
02-28-1997 08:53:33  
*Kathy S. Mahar*  
Kathy S. Mahar, Register  
REGISTER OF DEEDS

For corners in

Luce \_\_\_\_\_ Located In: \_\_\_\_\_ Corner Code # \_\_\_\_\_  
(County)

- |                                    |                |   |
|------------------------------------|----------------|---|
| 1. Public Land Survey              | T46N R10W      | <input checked="" type="checkbox"/> C-1 Same    |
|                                    | T47N R10W      | <input checked="" type="checkbox"/> C-13 Corner |
|                                    | T___ R___      | _____   |
|                                    | T___ R___      | _____   |
| 2. Property Controlling in Section | S___ T___ R___ | _____   |
|                                    | S___ T___ R___ | _____   |
| 3. Miscellaneous Property in Sec.  | S___ T___ R___ | _____   |
|                                    | S___ T___ R___ | _____   |

Register of Deeds Stamp & File Number

4. Lot No. \_\_\_\_\_, Recorded Plat \_\_\_\_\_  
5. Private Claims \_\_\_\_\_

I, Keith R. Waters, in a field survey on 11/02, 1996 do hereby state that under requirements of P.A. 74, Michigan P.A. of 1970, the corner points mentioned in lines 1 and 2 above were in conformance with regulations and rules therefore as required in the current manual of survey instructions of the United States Department of the Interior, Bureau of Land Management or by a decree of a Court of Law and /or that the corner points mentioned in lines 3, 4 and 5 above were in conformance with the rules of the Michigan Board of Land Surveyors or by a Decree of a Court of Law, established, re-established, monumented, recovered, found as expressed below:

NOTE: Not more than 2 corners, all in the same town and range, may be recorded on this certificate.


A	B	C	D	E	F	G	H	I	J	K	L
1											
2	6		5		4		3		2		1
3											
4	7		8		9		10		11		12
5											
6	18		17		16		15		14		13
7											
8	19		20		21		22		23		24
9											
10	30		29		28		27		26		25
11											
12	31		32		33		34		35		36
13											

A. Description of original monument and accessories and/or subsequent restoration:

C-1 (C-13) Corner Common to Sections 5 & 6, T46N, R10W & Sections 31 & 32, T47N, R10W  
1841 - Original ties to set post (John Burt): Sugar 16, N60°E 54 links - Sugar 15, N31°W 50 links.  
1960 - Billy D. Buckler, RLS 8887, page 392A of Luce County recorded corners. Corner re-established from old fence lines in the area. Placed a 1" iron pipe. Witnesses: 5" Jack Pine, N65°W 64½ links.

B. Description of corner evidence found and/or method applied in restoring or reestablishing corner:

This corner is being perpetuated as part of the Luce County Remonumentation Program.  
Found a 1" iron pipe approximately 3 feet south of east-west dirt road. Found no evidence of Buckler's bearing tree. Measurements to other recovered corners on the township line confirm that the pipe is in the corner location as established by Buckler. Accepted corner as found and established new witness objects.

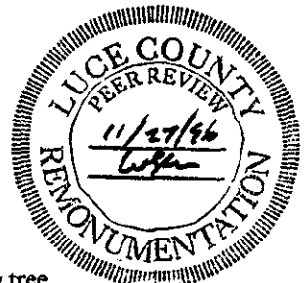

C. Description of monument for corner and accessories established to perpetuate locating the position of the corner:

Corner is 1" iron pipe approximately 3 feet south of the centerline of an east-west dirt road.  
Witnesses:  
9" Jack Pine, N39°W 33.52'  
11" Jack Pine, S66°W 57.18'  
Power Pole (ML1-195), N34°E 61.73'  
14" Red Pine, N72°W 138.58'

Note: Distances are to a nail/tag P.S. 33142 in the side of the witness object. Trees are blazed and painted. Bearings are compass bearings corrected for declination.



Signed by Keith R. Waters  
Surveyor's Michigan License No. 33142

Date 12-30-96