

**APR 07 1998**

**LAND CORNER RECORDATION CERTIFICATE**  
**Filing Requirement of Act 74, Mich. P.A. 1970**  
**Luce County Remonumentation Corner**

For corners in SECTION

Luce County	Located in:	Corner Code #
1. Public Land Survey	T46N R10W	E-3
	T R	
	T R	
	T R	
2. Property Controlling in Section	S T R	
	S T R	
3. Miscellaneous Property in Sec.	S T R	
	S T R	
4. Lot No.	Recorded Plat	
5. Private Claims		

LUCE COUNTY  
 REGISTER OF DEEDS  
 Recorded  
*Liber 3 Page 792*  
 03-06-1998 10:45:39  
*Deborah Johnson, Dep.*  
 Kathy S. Maher, Register  
 REGISTER OF DEEDS

Register of Deeds Stamp & File Number

	A	B	C	D	E	F	G	H	I	J	K	L	M
1													
2	6		5		4		3		2				
3													
4	7		8		9		10		11				
5													
6	18		17		16		15		14				
7													
8													
9													
10													
11													
12													

I, Keith R. Waters, in a field survey on September 16, 1997, do hereby state that under requirements of P.A. 74, Michigan P.A. of 1970, the corner points mentioned in lines 1 and 2 above were in conformance with regulations and rules therefore as required in the current manual of survey instructions of the United States Department of the Interior, Bureau of Land Management or by a decree of a Court of Law and for that the corner points mentioned in lines 3, 4 and 5 above were in conformance with the rules of the Michigan Board of Land Surveyors or by a Decree of a Court of Law; established, re-established, monumented, recovered, found as expressed below:

NOTE: Not more than 2 corners, all in the same town and range, may be recorded on this certificate.

A. Description of original monument and accessories and/or subsequent restoration:

E-3 Corner common to Sections 4, 5, 8, & 9, Town 46 North, Range 10 West

1853 - Original corner was established by George H. Cannon, D.S.

Witnesses: White Pine 20, S44°E 51 links  
 Yellow Birch 17, N25°W 21 links

1957 - Michigan Department of Conservation, Forestry Division, Land Corner Record, Billy D. Buckler, R.L.S. 8887  
 Recorded in Luce County Corner Records, page 167A. Replaced section corner from one probable original BT (white pine), down and rotted. Position fits very well with other corners in the area.  
 Witnesses: 8" Cedar, S15°E 32 links - 9" Cedar, S70°W 118 links - 9" White Pine, N88°E 52 links

B. Description of corner evidence found and/or method applied in restoring or reestablishing corner:


This corner is being perpetuated as part of the Luce County Remonumentation Program.  
 Found a 1" iron pipe with a brass DNR cap and the bearing tree called out as an 8" cedar in the 1957 DNR records.  
 Accepted corner as found and established additional bearing trees.

C. Description of monument for corner and accessories established to perpetuate locating the position of the corner:

Found a 1" iron pipe with a brass DNR cap at the corner location, which falls on the north edge of a swamp.  
 Witnesses:

- 10" Cedar, N30°E 27.86'
- 12" Cedar, S22°E 21.98'
- 10" Black Spruce, S70°W 19.27'
- 8" Cedar, S64°E 4.92'

Note: Distances are to a nail/tag #33142 in the side of the tree.  
 Trees are blazed and painted.  
 Bearings are compass bearings corrected for declination.

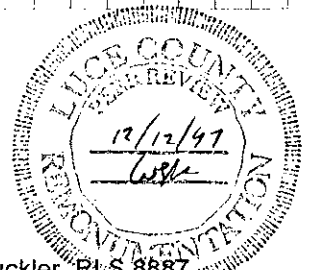

Signed by Keith R. Waters

Date 12-30-97

Surveyor's Michigan License No. 33142