

MAR 10 1999

SECTION

LAND CORNER RECORDATION CERTIFICATE
Filing Requirement of Act 74, Mich. P.A. 1970
Luce County Remonumentation Corners

For corners in


Table with columns: Luce County, Located in:, Corner Code #. Rows include Public Land Survey, Property Controlling in Section, Miscellaneous Property in Sec., Lot No., and Private Claims.

LUCE COUNTY
REGISTER OF DEEDS
Recorded

Liber 3 Page 864
02-25-1999 15:39:07

Deborah Johnson, Dep.
Kathy S. Naha, Register
REGISTER OF DEEDS

Register of Deeds Stamp & File Number

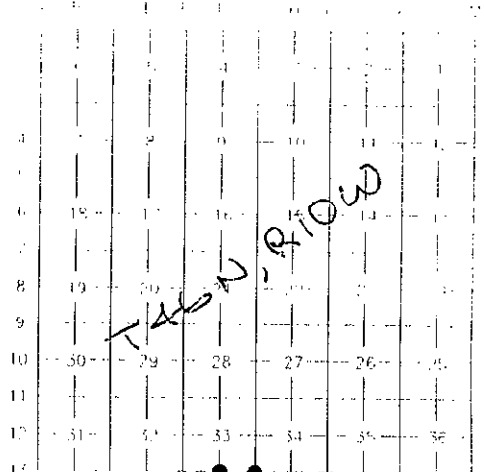

I, Keith R. Waters, in a field survey on July 30, 1998, do hereby state that under requirements of P.A. 74, Michigan P.A. of 1970, the corner points mentioned in lines 1 and 2 above were in conformance with regulations and rules therefore as required in the current manual of survey instructions of the United States Department of the Interior, Bureau of Land Management or by a decree of a Court of Law and for that the corner points mentioned in lines 3, 4 and 5 above were in conformance with the rules of the Michigan Board of Land Surveyors or by a Decree of a Court of Law; established, re-established, monumented, recovered, found as expressed below.

NOTE: Not more than 2 corners, all in the same town and range, may be recorded on this certificate.

A. Description of original monument and accessories and/or subsequent restoration:
F-13 1/4 Corner Common to Sec. 4, T45N, R10W & Sec. 33, T46N, R10W

1841 - Original corner was established by William A. Burt.
Witnesses: Tamarack 14, N80°E 26 links - Tamarack 8, N55°W 58 links.
Found no evidence of subsequent restoration of this corner.

G-13 Corner Common to Secs. 3 & 4, T45N, R10W & Secs. 33 & 34, T46N, R10W

1841 - Original corner was established by William A. Burt.
Witnesses: Tamarack 10, N44°E 30 links - Tamarack 8, N34°W 30 links.
1849 - Witnesses added by William Ives during the subdivision of Town 45 North, Range 10 West:
Spruce 7, S60°E 34 links - Tamarack 7, S42°W 43 links.
Found no evidence of subsequent restoration of this corner.

B. Description of corner evidence found and/or method applied in restoring or reestablishing corner:

F-13
This corner is being reestablished as part of the Luce County Remonumentation Program.
Found no evidence of the original corner. Reestablished corner by single proportionate measurement on the township line between recovered corners at A-13 and I-13.

G-13
This corner is being reestablished as part of the Luce County Remonumentation Program.
Found no evidence of the original corner. Reestablished corner by single proportionate measurement on the township line between recovered corners at A-13 and I-13.

C. Description of monument for corner and accessories established to perpetuate locating the position of the corner:

F-13
Placed a 1/2" x 48"± rebar with a stamped aluminum Luce County Remonumentation cap at the corner location.
Witnesses:
Nail and tag #33142 in side of blazed 6" Tamarack, N68°E 51.79'
Nail and tag #33142 in side of blazed 10" White Pine, S29°E 95.18'
Nail and tag #33142 in side of blazed 4" Tamarack, S10°E 6.99'
Nail and tag #33142 in side of blazed 4" Black Spruce, N55°W 32.38'

G-13
Placed a 1/2" x 48"± rebar with a stamped aluminum Luce County Remonumentation cap at the corner location, which falls 40.4 feet west of the centerline of County Road 405 (Dollarville Road). Witnesses:
Nail and tag #33142 in side of blazed 9" Spruce, WEST 93.56'
Nail and tag #33142 in side of blazed 8" Spruce, N38°W 48.13'
Nail and tag #33142 in side of blazed 9" Spruce, N84°E 93.94'
Nail and tag #33142 in side of blazed 7" White Birch, N61°E 93.72'

Signed by Keith R. Waters

Date 12-29-98

Surveyor's Michigan License No. 33142

