

**SURVEY & REMONUMENTATION**

APR 07 1998

**LAND CORNER RECORDATION CERTIFICATE**  
**Filing Requirement of Act 74, Mich. P.A. 1970**  
 Luce County Remonumentation Corner

**SECTION**

For corners in

Luce County	Located in:	Corner Code #
1. Public Land Survey	T46N R10W	G-3
	T R	
	T R	
2. Property Controlling in Section	S T R	
	S T R	
3. Miscellaneous Property in Sec.	S T R	
	S T R	
4. Lot No. , Recorded Plat		
5. Private Claims		

LUCE COUNTY  
 REGISTER OF DEEDS  
 Recorded  
*Liber 3 Page 795*  
 03-06-1998 10:46:09  
*Deborah Johnson, Dep.*  
 Kathy S. Malar, Register  
 REGISTER OF DEEDS

Register of Deeds Stamp & File Number

I, Keith R. Waters, in a field survey on October 28, 1997, do hereby state that under requirements of P.A. 74, Michigan P.A. of 1970, the corner points mentioned in lines 1 and 2 above were in conformance with regulations and rules therefore as required in the current manual of survey instructions of the United States Department of the Interior, Bureau of Land Management or by a decree of a Court of Law and /or that the corner points mentioned in lines 3, 4 and 5 above were in conformance with the rules of the Michigan Board of Land Surveyors or by a Decree of a Court of Law, established, re-established, monumented, recovered, found as expressed below:

NOTE: Not more than 2 corners, all in the same town and range, may be recorded on this certificate.

A. Description of original monument and accessories and/or subsequent restoration:

G-3 Corner common to Sections 3, 4, 9, & 10, T46N, R10W

1853 - Original corner was established by George H. Cannon, D.S.

Witnesses: Cedar 12, S35°E 23 links  
 Cedar 14, N35°W 48 links

1957 - Michigan Department of Conservation, Forestry Division, Land Corner Record, Billy D. Buckler, RLS 8887. Recorded in Luce County Corner Records, page 164A. Replaced corner from two original cedar bearing tree stumps. Both stumps down and in poor condition, scribe marks plain on northwest stump.  
 Witnesses: 7" Cedar, N86°E 33 links - 8" Cedar, S48°E 34 links.

B. Description of corner evidence found and/or method applied in restoring or reestablishing corner:



This corner is being perpetuated as part of the Luce County Remonumentation Program. Found a 1" iron pipe with a brass DNR cap and the two cedar bearing trees as called for in the 1957 DNR records, the cedar northeast is in very poor condition. Accepted corner as found and established additional bearing trees.

C. Description of monument for corner and accessories established to perpetuate locating the position of the corner:

Found a 1" iron pipe with a brass DNR cap at the corner location, next to a squared, scribed wood post.  
 Witnesses:

- 12" Cedar, N79°E 21.58'
- 14" Cedar, S52°E 22.84'
- 10" Cedar, S16°E 10.22'
- 9" Tamarack, N56°W 26.25'
- 5" Cedar, N25°E 14.74'

Note: Distances are to a nail/tag #33142 in the side of the tree.  
 Trees are blazed and painted.  
 Bearings are compass bearings corrected for declination.

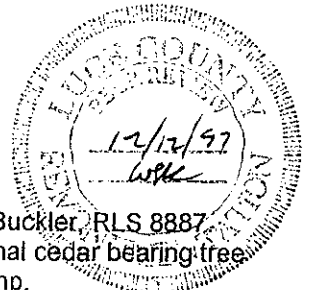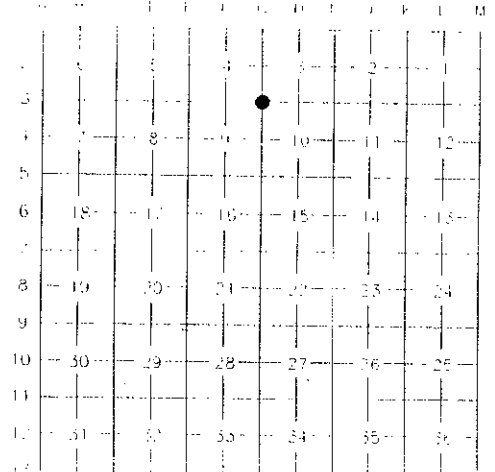

Signed by Keith R. Waters

Date 12-30-97

Surveyor's Michigan License No. 33142