

SURVEY & REMONUMENTATION

APR 07 1998

LAND CORNER RECORDATION CERTIFICATE
Filing Requirement of Act 74, Mich. P.A. 1970
Luce County Remonumentation Corner

For corners in

Luce County **SECTION**

	Located in:	Corner Code #
1. Public Land Survey	T46N R10W	G-4
	T R	
	T R	
	T R	
2. Property Controlling in Section	S T R	
	S T R	
3. Miscellaneous Property in Sec.	S T R	
	S T R	
4. Lot No.	Recorded Plat	
5. Private Claims		

LUCE COUNTY
 REGISTER OF DEEDS
 Recorded

Liber 3 Page 796
 03-06-1998 10:46:19
Nelora Johnson, Dep.
 Katha S. Mahar, Register
 REGISTER OF DEEDS

Register of Deeds Stamp & File Number

	A	B	C	D	E	F	G	H	I	J	K	L	M
1													
2													
I, Keith R. Waters, in a field survey on October 3, 1997, do hereby state that under requirements of P.A. 74, Michigan P.A. of 1970, the corner points mentioned in lines 1 and 2 above were in conformance with regulations and rules therefore as required in the current manual of survey instructions of the United States Department of the Interior, Bureau of Land Management or by a decree of a Court of Law and /or that the corner points mentioned in lines 3, 4 and 5 above were in conformance with the rules of the Michigan Board of Land Surveyors or by a Decree of a Court of Law; established, re-established, monumented, recovered, found as expressed below:

NOTE: Not more than 2 corners, all in the same town and range, may be recorded on this certificate.

A. Description of original monument and accessories and/or subsequent restoration:

G-4 1/4 Corner common to Sections 9 & 10, Town 46 North, Range 10 West

1853 - Original corner was established by George H. Cannon, D.S.

Witnesses: Maple 7, S36°W 10 links
 Hemlock 24, S34°E 19 links

Found no evidence of subsequent restoration of this corner.

B. Description of corner evidence found and/or method applied in restoring or reestablishing corner:


This corner is being reestablished as part of the Luce County Remonumentation Program. Found no evidence of this corner or its accessories. Reestablished corner by single proportionate measurement midway on line between section corners north and south.

C. Description of monument for corner and accessories established to perpetuate locating the position of the corner:

Placed a 1/2" x 18" rebar with a stamped aluminum Luce County Remonumentation cap at the corner location, which falls on the west edge of a red pine plantation, approximately 300 feet north of the Camp Six Road.
 Witnesses:

- 10" Red Pine, N16°E 14.91'
- 6" Red Pine, N61°E 13.05'
- 7" Red Pine, S13°E 18.36'
- 8" Cherry, WEST 50.45'

Note: Distances are to a nail/tag #33142 in the side of the tree.
 Trees are blazed and painted.
 Bearings are compass bearings corrected for declination.

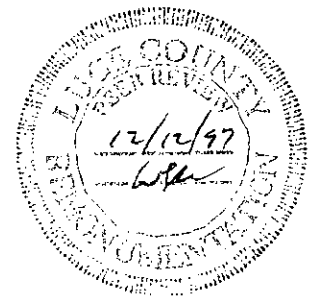

Signed by Keith R. Waters

Date 12-30-97

Surveyor's Michigan License No. 33142