

SURVEY & REMONUMENTATION

APR 07 1998

LAND CORNER RECORDATION CERTIFICATE

Filing Requirement of Act 74, Mich. P.A. 1970

Luce County Remonumentation Corner

For corners in **SECTION**

Luce County	Located in:	Corner Code #
1. Public Land Survey	T46N R10W	G-5
	T R	
	T R	
	T R	
2. Property Controlling in Section	S T R	
	S T R	
3. Miscellaneous Property in Sec.	S T R	
	S T R	
4. Lot No.	Recorded Plat	
5. Private Claims		

LUCE COUNTY

REGISTER OF DEEDS

Recorded

Liber 3 Page 797

03-06-1998 10:46:31

Deborah Johnson, Dep.

Kathy S. Mahar, Register

REGISTER OF DEEDS

Register of Deeds Stamp & File Number

I, Keith R. Waters, in a field survey on September 16, 1997, do hereby state that under requirements of P.A. 74, Michigan P.A. of 1970, the corner points mentioned in lines 1 and 2 above were in conformance with regulations and rules therefore as required in the current manual of survey instructions of the United States Department of the Interior, Bureau of Land Management or by a decree of a Court of Law and /or that the corner points mentioned in lines 3, 4 and 5 above were in conformance with the rules of the Michigan Board of Land Surveyors or by a Decree of a Court of Law; established, re-established, monumented, recovered, found as expressed below:

NOTE: Not more than 2 corners, all in the same town and range, may be recorded on this certificate.

A. Description of original monument and accessories and/or subsequent restoration:


G-5 Corner common to Sections 9, 10, 15, & 16, Town 46 North, Range 10 West

1853 - Original corner was established by George H. Cannon, D.S.

Witnesses: Cedar 14, S64°E 23½ links
Yellow Birch 20, S82°W 12 links

1974 - LCRC page 173, Luce County Corner Records, Billy D. Buckler, RLS 8887. Replaced from two possible original bearings trees in proper position, cedar and yellow birch. Also an original line tree 9.96 chains to the north:

Witnesses: 6" White Birch, N85°W 28.0' - 8" Black Spruce, S75°E 10.5'

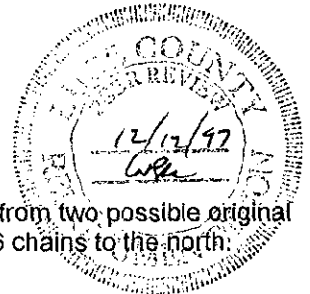

B. Description of corner evidence found and/or method applied in restoring or reestablishing corner:

This corner is being perpetuated as part of the Luce County Remonumentation Program.

Found a 1" iron pipe with an aluminum DNR cap and the black spruce bearing tree as called for in 1974 LCRC. It appears that the distances are reversed on the bearing trees, the distance to the found spruce is 28.10 feet.

Accepted corner as found and established additional witness trees.

C. Description of monument for corner and accessories established to perpetuate locating the position of the corner:

Found a 1" pipe with an aluminum DNR cap at the corner location.

Witnesses:

10" Black Spruce, S75°E 28.10'
4" Poplar, S49°W 25.25'
5" Black Spruce, N85°W 48.66'
2" White Birch, N64°W 50.24'

Note: Distances are to a nail/tag #33142 in the side of the tree.

Trees are blazed and painted.

Bearings are compass bearings corrected for declination.



Signed by Keith R. Waters

Date 12-30-97

Surveyor's Michigan License No. 33142