

LUCE COUNTY REMONUMENTATION CORNER

1993

LAND CORNER RECORDATION CERTIFICATE
Filing Requirement of Act 74, Mich. P.A. 1970

COMMISSION

For corners in Luce

(County)	Located In:	Corner Code #
1. Public Land Survey	T 46N R 10W	J-9
	T R	
	T R	
	T R	
2. Property Controlling in Section	S T R	
	S T R	
3. Miscellaneous Property in Sec.	S T R	
	S T R	
4. Lot No. _____, Recorded Plat _____		
5. Private Claims _____		

Filed 12-22 A.D., 19 93

At 10:00 o'clock A.M.

File No. 99 504

Keith R. Waters
Luce County Reg. of Deeds

Register of Deeds Stamp & File Number

I, Keith R. Waters, in a field survey on October, 19 93

do hereby certify that under requirements of P.A. 74, Michigan P.A. of 1970, the corner points mentioned in lines 1 and 2 above were in conformance with regulations and rules therefore as required in the current manual of survey instructions of the United States Department of the Interior, Bureau of Land Management or by a decree of a Court of Law and/or that the corner points mentioned in lines 3, 4 and 5 above were in conformance with the rules of the Michigan Board of Land Surveyors or by a Decree of a Court of Law; established, re-established, monumented, re-monumented, recovered, found as expressed below:

NOTE: Not more than 4 corners, all in the same town and range, may be recorded on this certificate.

A. Description of original monument and accessories and/or subsequent restoration:

J-9 1/4 Corner Common to Sections 23 & 26, T46N, R10W

Original ties to post:
Balsam 11, S78°W 11 links
Cedar 10, N33°E 8 links

B. Description of corner evidence found and/or method applied in restoring or reestablishing corner:

J-9

This corner is being re-established as part of the Luce County Remonumentation Program. Found no evidence of corner. Re-established corner at split of right-of-way fences on north and south sides of east-west gravel road (County Road 400) on line with an old fence line to the south. Corner is on line with the split of right-of-way fences at 1/16 line to the east and established Section corner 1/2 mile east. East-west position is at the split of said Section corner to the east and remains of an old north-south fence line on the west line of Section 26, T46N, R10W.


C. Description of monument for corner and accessories established to perpetuate locating the position of the corner:

J-9

Corner is a 1/2" rebar with 3 1/4" aluminum Luce County cap approximately 3 feet south of centerline of east-west gravel road (County Road 400) at remains of fence line to the south. Witnesses:

- 12" Red Pine, SOUTH 81.32'
- Fence Post, S14°W 45.60'
- 5" Spruce, S31°E 86.52'
- 3" Spruce, N78°W 131.58'

Note: Distances are to a nail and tag in the side of witness object. Trees are blazed and painted. Bearings are compass bearings corrected for declination.

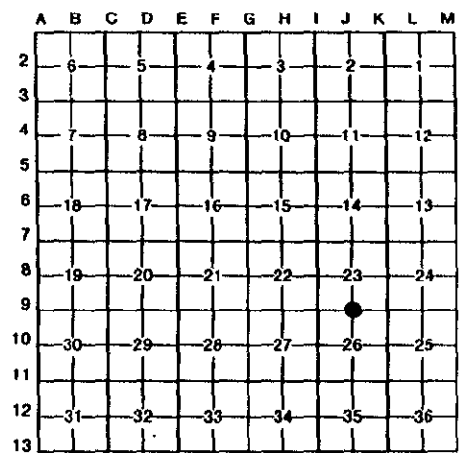

Signed by Keith R. Waters

Date 12-20-93

Surveyor's Michigan License No. 33142