

SURVEY & REMONUMENTATION

APR 07 1998

LAND CORNER RECORDATION CERTIFICATE
Filing Requirement of Act 74, Mich. P.A. 1970
 Luce County Remonumentation Corner

For corner **SECTION**

Luce County	Located in:	Corner Code #
1. Public Land Survey	T46N R10W	K-2
	T R	
	T R	
	T R	
2. Property Controlling in Section	S T R	
	S T R	
3. Miscellaneous Property in Sec.	S T R	
	S T R	

LUCE COUNTY
 REGISTER OF DEEDS
 Recorded
Liber 3 Page 806
 03-06-1998 10:47:56
Deborah Johnson, Dep.
 Kathy S. Mahar, Register
 REGISTER OF DEEDS

Register of Deeds Stamp & File Number

- 4. Lot No. , Recorded Plat .
- 5. Private Claims

I, Keith R. Waters, in a field survey on December 22, 1997, do hereby state that under requirements of P.A. 74, Michigan P.A. of 1970, the corner points mentioned in lines 1 and 2 above were in conformance with regulations and rules therefore as required in the current manual of survey instructions of the United States Department of the Interior, Bureau of Land Management or by a decree of a Court of Law and /or that the corner points mentioned in lines 3, 4 and 5 above were in conformance with the rules of the Michigan Board of Land Surveyors or by a Decree of a Court of Law; established, re-established, monumented, recovered, found as expressed below:

NOTE: Not more than 2 corners, all in the same town and range, may be recorded on this certificate.

A. Description of original monument and accessories and/or subsequent restoration:

K-2 ¼ Corner common to Sections 1 & 2, Town 46 North, Range 10 West

1853 - Original corner was established by George H. Cannon, D.S.
 Witnesses: Hemlock 12, N34°W 27 links
 Cedar 12, S34°E 18 links

Found no evidence of subsequent restoration of this corner.

B. Description of corner evidence found and/or method applied in restoring or reestablishing corner:



This corner is being reestablished as part of the Luce County Remonumentation Program.
 Found no evidence of this corner or its accessories. Reestablished corner by single proportionate measurement between section corner K-1 on the township line 2750.9 feet (GLO is 2758) to the north and section corner K-3 2633.1 feet (GLO is 2640) to the south.
 (Note: The position used for the section corner K-3 is not the previously recorded position as shown in LCRC's in liber 2, pages 641, 680, and 683).

C. Description of monument for corner and accessories established to perpetuate locating the position of the corner:

Placed a ½" rebar with a plastic cap #33142 at the corner location, which falls approximately 2 feet east of the centerline of Highway M123 and 5 feet south of the centerline of County Road 450 to the west.
 Witnesses:

- Power Pole, N61°W 77.06'
- 6" Balsam Fir, S45°W 169.27'
- Power Pole, S36°E 116.18'
- Power Pole, N58°E 79.56'

Note: Distances are to a nail/tag #33142 in the side of the witness object.
 Bearings are compass bearings corrected for declination.

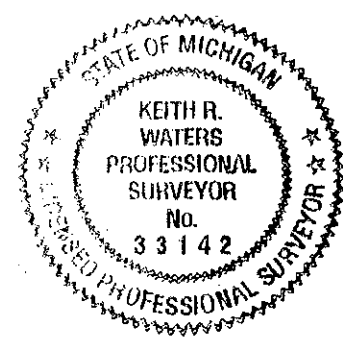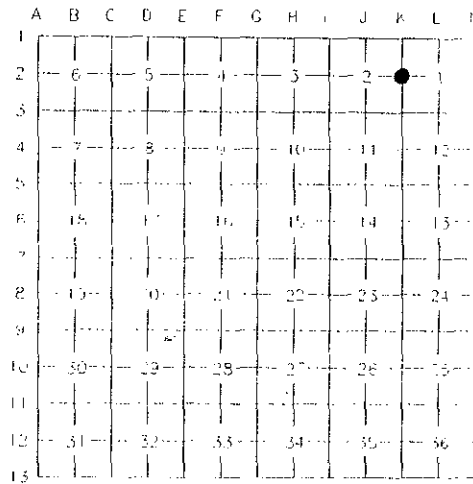

Signed by Keith R. Waters

Date 12-30-97

Surveyor's Michigan License No. 33142