

SURVEY & REMONUMENTATION

APR 07 1998

LAND CORNER RECORDATION CERTIFICATE Filing Requirement of Act 74, Mich. P.A. 1970 Luce County Remonumentation Corner

For corner **SECTION**

Luce County	Located in:	Corner Code #
1. Public Land Survey	T46N R10W	K-6
	T R	
	T R	
	T R	
2. Property Controlling in Section	S T R	
	S T R	
3. Miscellaneous Property in Sec.	S T R	
	S T R	
4. Lot No.	Recorded Plat	
5. Private Claims		

LUCE COUNTY
REGISTER OF DEEDS
Recorded
Liber 3 Page 810
03-06-1998 10:48:43
Deborah Johnson, Dep.
Kathy S. Mahar, Register
REGISTER OF DEEDS

Register of Deeds Stamp & File Number

I, Keith R. Waters, in a field survey on December 16, 1997, do hereby state that under requirements of P.A. 74, Michigan P.A. of 1970, the corner points mentioned in lines 1 and 2 above were in conformance with regulations and rules therefore as required in the current manual of survey instructions of the United States Department of the Interior, Bureau of Land Management or by a decree of a Court of Law and /or that the corner points mentioned in lines 3, 4 and 5 above were in conformance with the rules of the Michigan Board of Land Surveyors or by a Decree of a Court of Law; established, re-established, monumented, recovered, found as expressed below:

NOTE: Not more than 2 corners, all in the same town and range, may be recorded on this certificate.

A. Description of original monument and accessories and/or subsequent restoration:

K-6 1/4 Corner common to Sections 13 & 14, Town 46 North, Range 10 West

1853 - Original corner was established by George H. Cannon, D.S.
Witnesses: Cedar 9, S72°E 26 links - Cedar 9, S77°W 27 links

1946 - A letter from Harold Lawrence, RLS 3218, to Thomas Dundon, RLS 3126, concerning corners on the River Road (now M123) north of Newberry, indicates an original corner at this location. An original cedar stump with scribe marks is noted. He also indicates a distance from the only other corner that he had found on the River Road, section corner K-9 1 1/2 miles to the south.

B. Description of corner evidence found and/or method applied in restoring or reestablishing corner:

This corner is being reestablished as part of the Luce County Remonumentation Program. Found no evidence of this corner or its accessories. Reestablished the corner at the record distance as indicated in above mentioned Lawrence notes north from recovered section corner K-9 to the south, on line between existing section corner K-5 2633.9 feet (GLO is 2640) to the north and existing section corner K-7 2584.0 feet (GLO is 2640) to the south. Using this reestablished position, the existing recorded section corners K-5 and K-3 to the north are both within 1 foot of a prorated north-south GLO distance to the existing recorded corner K-1 on the township line. The short distance south to section corner K-7 is, I believe, a result of said existing recorded corner at K-7 being too far north based on Lawrence's notes. This is explained further in my LCRC for corner K-7.


C. Description of monument for corner and accessories established to perpetuate locating the position of the corner:

Placed a 1/2" rebar with a plastic cap #33142 at the corner location, which falls approximately 1 foot west of the centerline of Highway M123.
Witnesses:

- 12" Cedar, N36°W 149.25'
- Utility Pole, N55°W 85.89'
- 12" White Birch, S80°W 103.71'
- 18" Tamarack, S64°E 114.72'

Note: Distances are to a nail/tag #33142 in the side of the witness object.
Bearings are compass bearing corrected for declination.

	A	B	C	D	E	F	G	H	I	J	K	L	M
1													
2	6	5	4	3	2	1							
3													
4	7	8	9	10	11	12							
5													
6	18	17	16	15	14	13							
7													
8	19	20	21	22	23	24							
9													
10	30	29	28	27	26	25							
11													
12	31	32	33	34	35	36							
13													

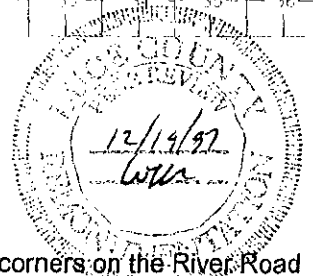

Signed by Keith R. Waters

Date 12-30-97

Surveyor's Michigan License No. 33142