

LUCE COUNTY REMONUMENTATION CORNER

1993

LAND CORNER RECORDATION CERTIFICATE
Filing Requirement of Act 74, Mich. P.A. 1970

COMMISSION

For corners in
Luce

(County)	Located In:	Corner Code #
1. Public Land Survey	T 46N R 10W	K-9
	T _____ R _____	_____
	T _____ R _____	_____
	T _____ R _____	_____
2. Property Controlling in Section	S _____ T _____ R _____	_____
	S _____ T _____ R _____	_____
3. Miscellaneous Property in Sec.	S _____ T _____ R _____	_____
	S _____ T _____ R _____	_____
4. Lot No. _____, Recorded Plat _____		
5. Private Claims _____		

Filed 12-22 A.D., 1993

At 10:00 o'clock A.M.

File No. 96 506

Keith R. Waters
Luce County Reg. of Deeds

Register of Deeds Stamp & File Number

I, Keith R. Waters, in a field survey on October, 1993

do hereby certify that under requirements of P.A. 74, Michigan P.A. of 1970, the corner points mentioned in lines 1 and 2 above were in conformance with regulations and rules therefore as required in the current manual of survey instructions of the United States Department of the Interior, Bureau of Land Management or by a decree of a Court of Law and/or that the corner points mentioned in lines 3, 4 and 5 above were in conformance with the rules of the Michigan Board of Land Surveyors or by a Decree of a Court of Law; established, re-established, monumented, re-monumented, recovered, found as expressed below:

NOTE: Not more than 4 corners, all in the same town and range, may be recorded on this certificate.


A. Description of original monument and accessories and/or subsequent restoration:

K-9 Corner Common to Sections 23, 24, 25, & 26, T46N, R10W

Original ties to post:	1977 - This corner is shown on MDOT Luce County
Spruce 7, S10°W 18 links	right-of-way maps, page 19, at station
Cedar 10, N26°E 19 links	16+13.21, 9.80' east of centerline of Highway
	M-123.

B. Description of corner evidence found and/or method applied in restoring or reestablishing corner:

K-9
This corner is being perpetuated as part of the Luce County Remonumentation Program. Found a 1" solid iron in a monument box 9.8' east of centerline on Highway M-123 at the intersection of County Road 400 to the east and County Road 462 to the west, as shown on right-of-way maps. Accepted corner found.

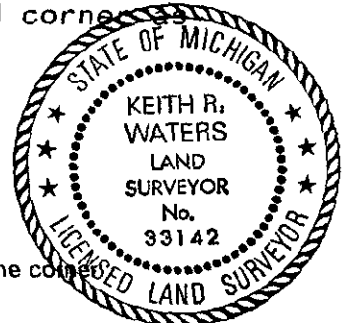

C. Description of monument for corner and accessories established to perpetuate locating the position of the corner:

K-9
Corner is a 1" solid iron in a monument box 9.8' east of centerline of Highway M-28, 3'± south of centerline of County Road 462 to the east, and 7'± south of centerline of County Road 400 to the west. Witnesses:

- Power Pole, N63°W 59.94'
- Power Pole (W&L-L3), N60°E 70.72'
- Center Top Nut on Hydrant, S60°E 75.61'
- Power Pole, (W&L), S36°E 97.46'
- Center Concrete R.O.W. Mon., S47°E 52.40'

Note: Unless noted otherwise, distances are to a nail and tag in the side of witness objects. Bearings are compass bearings corrected for declination.

Signed by Keith R. Waters Date 12-20-93

Surveyor's Michigan License No. 33142