

APR 0 7 1998

LAND CORNER RECORDATION CERTIFICATE Filing Requirement of Act 74, Mich. P.A. 1970 Luce County Remonumentation Corner

For corners in

Luce County Located in: Corner Code # 1. Public Land Survey T46N R10W Т R R 7 T R 2. Property Controlling S T R in Section S R T 3. Miscellaneous S R T Property in Sec. S R

LUCE COUNTY REGISTER OF DEEDS Recorded Liber 3 Page 815 03-06-1998 10:49:35 Delorah Joh. Kathu S. Mahar, REGISTER OF DEEDS

4. Lot No.

, Recorded Plat ,

5. Private Claims

I, Keith R. Waters, in a field survey on November 25, 1997, do hereby state that under requirements of P.A. 74, Michigan P.A. of 1970, the corner points mentioned in lines 1 and 2 above were in conformance with regulations and rules therefore as required in the current manual of survey instructions of the United States Department of the Interior, Bureau of Land Management or by a decree of a Court of Law and /or that the corner points mentioned in lines 3, 4 and 5 above were in conformance with the rules of the Michigan Board of Land Surveyors or by a Decree of a Court of Law; established, re-established, monumented, recovered, found as expressed below:

NOTE: Not more than 2 corners, all in the same town and range, may be recorded on this certificate.

A. Description of original monument and accessories and/or subsequent restoration:

L-7 1/2 Corner common to Sections 13 & 24, Town 46 North, Range 10 West

1853 - Original corner was established by George H. Cannon, D.S. Witnesses: Black Ash 13, N44°E 22 links Hemlock 12, S36°E 111/2 links

1946 - A letter from Harold Lawrence, RLS 3218, to Thomas Dundon, RLS 3126, indicates that he (Lawrence) reestablished this corner from the original hemlock bearing tree.

B. Description of corner evidence found and/or method applied in restoring or reestablishing corner:

This corner is being perpetuated as part of the Luce County Remonumentation Program. Found a leaning 6 foot high squared, scribed, wood post on the south side of the Tahquamenon River. Also found the remains of the stump of the hemlock bearing tree as described by Harold Lawrence in the above mentioned letter. The bearing and distance from the stump to the post fit record GLO measurements. The corner was pointed out to me by adjoining landowner, Mr. Ken Stephenson, who first saw the post in the 1960's when he purchased the property. Accepted corner location as found and placed a ½" x 48" rebar at the base of the post.

C. Description of monument for corner and accessories established to perpetuate locating the position of the corner:

Placed a 1/2" x 48" rebar with a stamped aluminum Luce County Remonumentation cap at the base of a found 6 foot high squared, scribed wood post at the corner position, which falls on the south side of the Tahquamenon River. Witnesses:

10" Balsam Fir, EAST 23.60' 7" Cedar, S30°W 22.49' 8" Elm. N79°W 14.25' 6" Black Ash, N29°W 10.32'

Note: Distances are to a nail/tag #33142 in the side of the tree. Trees are blazed and painted.

Bearings are compass bearings corrected for declination.


12-30-97

Surveyor's Michigan License No. 33142

FORM APPROVED BY MICHIGAN STATE BOARD OF PROFESSIONAL SURVEYORS, JAN. 28, 1971 REVISED MAY 14, 1975 REVISED JAN., 1983 REVISED OCT., 1995

LCRC T46N R10W L-7

Register of Deeds Stamp & File Number

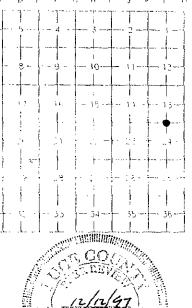

PSE OF MICH GA

WATERS PROLESSIONAL

SURVEYOR

No.

33142

ROFESSIONAL