

MAY 28 1997

COMMISSION

LUCE COUNTY REMONUMENTATION CORNER

LAND CORNER RECORDATION CERTIFICATE
 Filing Requirement of Act 74, Mich. P.A. 1970

LUCE COUNTY
 REGISTER OF DEEDS

Recorded

Liber 2 Page 720
 02-28-1997 08:56:12

Kathy S. Mahar
 Kathy S. Mahar, Register
 REGISTER OF DEEDS

Register of Deeds Stamp & File Number

For corners in

Luce _____ Located In: _____ Corner Code # _____
 (County)

1. Public Land Survey	T46N R 9W	<input checked="" type="checkbox"/> A-6	Same
	T46N R 10W	<input checked="" type="checkbox"/> M-6	Corner
	T _____ R _____		
	T _____ R _____		
2. Property Controlling in Section	S _____ T _____ R _____		
	S _____ T _____ R _____		
3. Miscellaneous Property in Sec.	S _____ T _____ R _____		
	S _____ T _____ R _____		

4. Lot No. _____, Recorded Plat _____
 5. Private Claims _____

I, Keith R. Waters, in a field survey on 07/26, 1996 do hereby state that under requirements of P.A. 74, Michigan P.A. of 1970, the corner points mentioned in lines 1 and 2 above were in conformance with regulations and rules therefore as required in the current manual of survey instructions of the United States Department of the Interior, Bureau of Land Management or by a decree of a Court of Law and for that the corner points mentioned in lines 3, 4 and 5 above were in conformance with the rules of the Michigan Board of Land Surveyors or by a Decree of a Court of Law, established, re-established, monumented, recovered, found as expressed below:

	A	B	C	D	E	F	G	H	I	J	K	L
1												
2		6		5		4		3		2		1
3												
4		7		8		9		10		11		12
5												
6		18		17		16		15		14		13
7												
8		19		20		21		22		23		24
9												
10		30		29		28		27		26		25
11												
12		31		32		33		34		35		36
13												


NOTE: Not more than 2 corners, all in the same town and range, may be recorded on this certificate.

A. Description of original monument and accessories and/or subsequent restoration:

A-6 (M-6) 1/4 Corner Common to Section 18, T46N, R9W & Section 13, T46N, R10W
 1841 - Original ties to set post (John Burt): Cedar 14, S35°W 10 links - Cedar 6, N22°E 10 links.
 1970 - Billy D. Buckler, RLS 8887, page 68 of Luce County recorded corners. Replaced corner at wood post set by H.C. Lawrence. Found numerous cedar stumps in area, could not identify any as original. Placed 1" pipe with aluminum cap at corner. Witness: 4" Cedar, N26°E 19.8'.

B. Description of corner evidence found and/or method applied in restoring or reestablishing corner:

This corner is being perpetuated as part of the Luce County Remonumentation Program.
 Found a 1" pipe with a stamped aluminum DNR cap approximately 290 feet north of the centerline of the Charcoal Grade Road.
 Also found Buckler's cedar bearing tree. Accepted corner as found and established additional bearing trees.

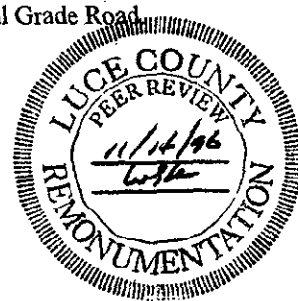

C. Description of monument for corner and accessories established to perpetuate locating the position of the corner:

Corner is a 1" iron pipe with a stamped aluminum DNR cap approximately 290 feet north of the centerline of the Charcoal Grade Road. Witnesses:
 9" Cedar, N26°E 19.40' (existing bearing tree)
 Twin 8" Cedar, S53°E 41.40'
 9" Cedar, S68°E 44.10'
 6" Cedar, N05°E 58.43'

Note: Distances are to a nail/tag P.S. 33142 in the side of the witness object. Trees are blazed and painted. Bearings are compass bearings corrected for declination.



Signed by Keith R. Waters
 Surveyor's Michigan License No. 33142

Date 12-30-96