

LUCE COUNTY REMONUMENTATION CORNER

1993

LAND CORNER RECORDATION CERTIFICATE
Filing Requirement of Act 74, Mich. P.A. 1970

COMMISSION

For corners in
Luce

(County)	Located In:	Corner Code #
1. Public Land Survey	T46N R 9W T46N R 10W T _____ R _____ T _____ R _____	A-9 Same M-9 Corner
2. Property Controlling in Section	S _____ T _____ R _____ S _____ T _____ R _____	
3. Miscellaneous Property in Sec.	S _____ T _____ R _____ S _____ T _____ R _____	
4. Lot No. _____, Recorded Plat _____		
5. Private Claims _____		

Filed 12-22 A.D., 1993

At 10:00 o'clock A.M.

File No. 99 503

Keith R. Waters
Luce County Reg. of Deeds

Register of Deeds Stamp & File Number

I, Keith R. Waters, in a field survey on October, 19 93, do hereby certify that under requirements of P.A. 74, Michigan P.A. of 1970, the corner points mentioned in lines 1 and 2 above were in conformance with regulations and rules therefore as required in the current manual of survey instructions of the United States Department of the Interior, Bureau of Land Management or by a decree of a Court of Law and/or that the corner points mentioned in lines 3, 4 and 5 above were in conformance with the rules of the Michigan Board of Land Surveyors or by a Decree of a Court of Law; established, re-established, monumented, re-monumented, recovered, found as expressed below:


NOTE: Not more than 4 corners, all in the same town and range, may be recorded on this certificate.

A	B	C	D	E	F	G	H	I	J	K	L	M
2	6	5	4	3	2	1						
3												
4	7	8	9	10	11	12						
5												
6	18	17	16	15	14	13						
7												
8	19	20	21	22	23	24						
9												
10	30	29	28	27	26	25						
11												
12	31	32	33	34	35	36						
13												

A. Description of original monument and accessories and/or subsequent restoration:

M-9 (T46N, R10W) Corner Common to Sections 19 & 30, T46N, R9W & Sections 24 & 25, T46N, R10W.

Original ties to post:
Cedar 13, S78°W 23 links
Cedar 12, N52°E 24 links

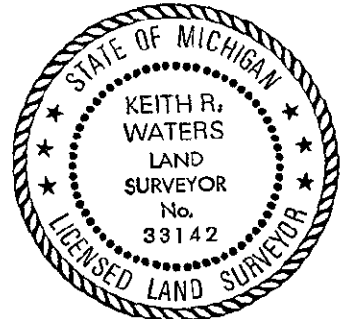

B. Description of corner evidence found and/or method applied in restoring or reestablishing corner:

M-9 (T46N, R10W)

This corner is being perpetuated as part of the Luce County Remonumentation Program. Found a railroad spike in asphalt pavement at the intersection of County Road 462 east-west and County Road 461 south. In talking with Eino Sainio, P.S. 7873, he indicated that he set the railroad spike as a perpetuation of a previous monument which was destroyed during road construction. Accepted corner position as found and replaced railroad spike with a 1/2" iron and 3/4" aluminum Luce County cap.

C. Description of monument for corner and accessories established to perpetuate locating the position of the corner:

M-9 (T46N, R10W)

Corner is a 1/2" rebar with 3/4" aluminum Luce County cap at the centerline of County Road 462 and the centerline of County Road 461 to the south.
Witnesses:

Power Pole (ML1-47), N40°W 48.09'
Anchor Pole, N45°E 52.82'
7" Aspen, S24°E 101.37'
Power Pole, S30°W 65.99'

Note: Distances are to a nail and tag in the side of witness object. Aspen is blazed and painted. Bearings are compass bearings corrected for declination.

Signed by Keith R. Waters

Date 12-20-93

Surveyor's Michigan License No. 33142