

**SURVEY &
REMONUMENTATION**

LUCE COUNTY REMONUMENTATION CORNER

APR 28 1995

COMMISSION

LAND CORNER RECORDATION CERTIFICATE
Filing Requirement of Act 74, Mich. P.A. 1970

For corners in
Luce

(County)

Located In:

Corner Code #

1. Public Land Survey


T 46N R 9W ✓ A-10 Same
T 46N R 10W M-10 Corner

2. Property Controlling
in Section
3. Miscellaneous
Property in Sec.

S T R
S T R
S T R
S T R

4. Lot No. _____, Recorded Plat _____

5. Private Claims _____

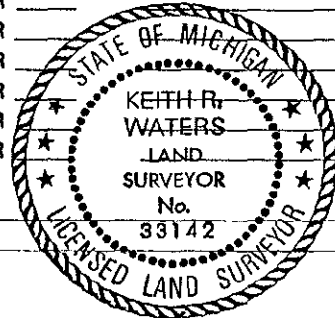

Filed 1/20 A.D., 1995

At 12:30 o'clock P. M.

File No. page 601

Kathy S. Mahan
Luce County Reg. of Deeds

Register of Deeds Stamp & File Number

	A	B	C	D	E	F	G	H	I	J	K	L	M
2	8	5	4	3	2	1							
3													
4	7	8	9	10	11	12							
5													
6	18	17	16	15	14	13							
7													
8	19	20	21	22	23	24							
9													
10	30	29	28	27	26	25							
11													
12	31	32	33	34	35	36							
13													

Keith R. Waters in a field survey on December 14, 1994

do hereby certify that under requirements of P.A. 74, Michigan P.A. of 1970, the corner points mentioned in lines 1 and 2 above were in conformance with regulations and rules therefore as required in the current manual of survey instructions of the United States Department of the Interior, Bureau of Land Management or by a decree of a Court of Law and/or that the corner points mentioned in lines 3, 4 and 5 above were in conformance with the rules of the Michigan Board of Land Surveyors or by a Decree of a Court of Law; established, re-established, monumented, re-monumented, recovered, found as expressed below:

NOTE: Not more than 4 corners, all in the same town and range, may be recorded on this certificate.

A. Description of original monument and accessories and/or subsequent restoration:

M-10 1/4 Corner Common to Section 30, T46N, R9W & Section 25, T46N, R10W

Original ties to post: Tamarack 7, S57°E 18 links Cedar 10, N62°W 27 links. 1980 - As recorded on page 278 of Luce County corner records, by Eino Sainio, P.S. 7873. Iron pipe in road set by County Surveyor Kinsey. Witness pipes have been removed by construction. Witnesses: Power Pole, N59°E 34.4' Power Pole, S35°E 45.4' Power Pole, S29°W 44.5' Corner is shown on several surveys by Eino Sainio.

B. Description of corner evidence found and/or method applied in restoring or reestablishing corner:

M-10 (T46N, R10W)

This corner is being perpetuated as part of the Luce County Remonumentation Program. 1" iron pipe and all witnesses as called for in 1980 records have been removed by road construction. Re-established corner from survey information obtained from Eino Sainio. Corner is 2634.50 feet from section corner to the north, 2635.88 feet from section corner to the south, and is 11.32 feet east of a straight line between said section corners.

C. Description of monument for corner and accessories established to perpetuate locating the position of the corner:

M-10 (T46N, R10W)

Corner is a 1/2" iron with plastic cap #33142 at the approximate centerline intersection of County Roads 461 north-south and 430 east-west. Witnesses:

Power Pole, N85°E 172.43'
Power Pole, N63°E 35.43'
Power Pole (118-22), N73°W 116.24'
Power Pole (ML1-37), S36°W 76.06'

Note: Distances are to a nail and tag in the side of the pole. Bearings are compass bearings corrected for declination.

Signed by Keith R. Waters

Date 12-23-94

Surveyor's Michigan License No. 33142