

SURVEY & REMONUMENTATION

APR 28 1995

LUCE COUNTY REMONUMENTATION CORNER

COMMISSION

LAND CORNER RECORDATION CERTIFICATE
Filing Requirement of Act 74, Mich. P.A. 1970

For corners in Luce

Located In: Corner Code #

1. Public Land Survey

T46N R 9W A-12 Same
T46N R 10W M-12 Corner

2. Property Controlling in Section


S T R
S T R

3. Miscellaneous Property in Sec.

S T R
S T R

4. Lot No. Recorded Plat

5. Private Claims

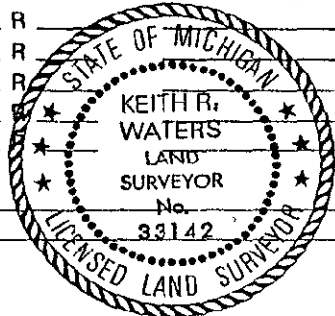

Filed 1/20 A.D., 1995

At 12:30 o'clock P.M.

File No. page 604

Keith R. Waters
Luce County Reg. of Deeds

Register of Deeds Stamp & File Number

	A	B	C	D	E	F	G	H	I	J	K	L	M
2	6	5	4	3	2	1							
3													
4	7	8	9	10	11	12							
5													
6	18	17	16	15	14	13							
7													
8	19	20	21	22	23	24							
9													
10	30	29	28	27	26	25							
11													
12	31	32	33	34	35	36							
13													

Keith R. Waters, in a field survey on November 2, 1994

do hereby certify that under requirements of P.A. 74, Michigan P.A. of 1970, the corner points mentioned in lines 1 and 2 above were in conformance with regulations and rules therefore as required in the current manual of survey instructions of the United States Department of the Interior, Bureau of Land Management or by a decree of a Court of Law and/or that the corner points mentioned in lines 3, 4 and 5 above were in conformance with the rules of the Michigan Board of Land Surveyors or by a Decree of a Court of Law; established, re-established, monumented, re-monumented, recovered, found as expressed below:

NOTE: Not more than 4 corners, all in the same town and range, may be recorded on this certificate.

A. Description of original monument and accessories and/or subsequent restoration:

M-12 1/4 Corner Common to Section 31, T46N, R9W & Section 36, T46N, R10W


Original ties to post: Sugar 7, S50°E 18 links Sugar 8, N63°W 11 links., 1973 - As recorded on page 132 of Luce County corner records, by Peter Chenard, RLS 14200. Set 1/2" bar on line between M-11 & M-13 opposite old fence west. Witnesses: P. Pole, S40°E 32.88' 8" Cherry, S15°E 85.14' P. Pole, S25°W 116.83'

Corner is shown as above on subsequent surveys by Peter Beaver, P.S. 25828 and Eino Sainio, P.S. 7873.

B. Description of corner evidence found and/or method applied in restoring or reestablishing corner:

M-12 (T46N, R10W)

This corner is being re-established as part of the Luce County Remonumentation Program. 1/2" iron has been removed by road construction. Found all three witness objects as shown in 1973 records. Re-established corner position using said witness objects. Position fits well with section corners north and south.

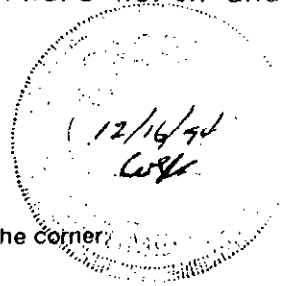

C. Description of monument for corner and accessories established to perpetuate locating the position of the corner:

M-12 (T46N, R10W)

Corner is a 1/2" iron with plastic cap #33142, approximately 9 feet east of the centerline of north-south asphalt road (County Road 461). Witnesses:

- Power Pole (Cut off), S40°E 32.88'
- Power Pole (New), S39°E 34.26'
- 10" Cherry, S15°E 85.14'
- Power Pole, S25°W 116.83'
- 12" Cherry, N70°E 30.56'

Note: Distances to new pole and cherry trees are to a nail and tag in the side. Distances to other two objects are to a nail and tag #14200 in the side. Bearings are compass bearings corrected for declination.

Signed by *Keith R. Waters*

Date 12-23-94

Surveyor's Michigan License No. 33142