

SURVEY & REMONUMENTATION

MAY 28 1997

LUCE COUNTY REMONUMENTATION CORNER

COMMISSION

LAND CORNER RECORDATION CERTIFICATE LUCE COUNTY
Filing Requirement of Act 74, Mich. P.A. 1970 REGISTER OF DEEDS

For corners in

<u>Luce</u> (County)	Located In:	Corner Code #
1. Public Land Survey	T45N R 11W T46N R 11W T___ R___ T___ R___	B-1 Same ✓ B-13 Corner
2. Property Controlling in Section	S___ T___ R___ S___ T___ R___	_____
3. Miscellaneous Property in Sec.	S___ T___ R___ S___ T___ R___	_____


Recorded
Liber 2 Page 731
02-28-1997 08:57:58
Kathy S. Maha
Kathy S. Maha, Register
REGISTER OF DEEDS

Register of Deeds Stamp & File Number


4. Lot No. _____, Recorded Plat _____
5. Private Claims _____

I, William L. Karr, in a field survey on Dec. 7, 1996 do hereby state that under requirements of P.A. 74, Michigan P.A. of 1970, the corner points mentioned in lines 1 and 2 above were in conformance with regulations and rules therefore as required in the current manual of survey instructions of the United States Department of the Interior, Bureau of Land Management or by a decree of a Court of Law and /or that the corner points mentioned in lines 3, 4 and 5 above were in conformance with the rules of the Michigan Board of Land Surveyors or by a Decree of a Court of Law; established, re-established, monumented, recovered, found as expressed below:

NOTE: Not more than 2 corners, all in the same town and range, may be recorded on this certificate.

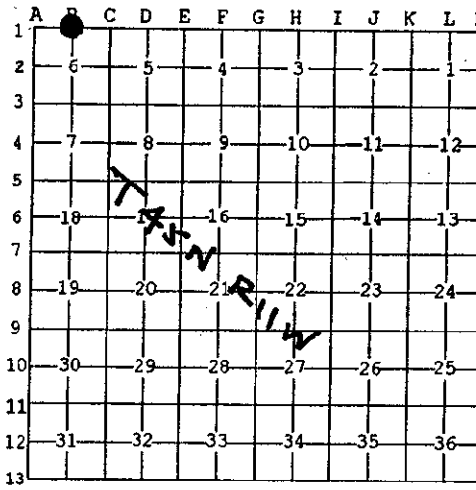

A. Description of original monument and accessories and/or subsequent restoration:
(B-1) 1/4 Corner Common to Section 6, T.45 N., R.11 W., and Section 31, T.46 N., R.11 W.
1841: W.A. Burt set 1/4 Section post Sugar 18 N78°E 41
Sugar 12 N64°W 111

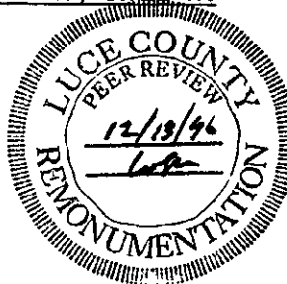

B. Description of corner evidence found and/or method applied in restoring or reestablishing corner:
(B-1) This Corner is being re-established as part of the Luce County Remonumentation Program.

Found no evidence of original corner. Found old fence line to the East and South. Re-established corner at the intersection of these fence lines. Distance to the East is 2634.33' (G.L.O. 2640.00'); distance West to the Township corner is 2558.53' (G.L.O. is 2558.82'). Corner is 3.75' North of a straight line between the corners.

C. Description of monument for corner and accessories established to perpetuate locating the position of the corner:
(B-1) Corner is a 1/2" x 24" iron with stamped aluminum Luce County Remonumentation cap. Fence lines to the South and East.

Witnesses: 5" Maple N41°E 4.00'
11" Oak S40°E 7.81'
6" Maple S82°W 9.12'
5" Maple N24°W 22.54'



Signed by William L. Karr
Surveyor's Michigan License No. 27450

Date 12-30-96

NOTE: All bearings are compass bearings corrected for declination. All distances are to a nail in side of witness objects unless noted.