


**LAND CORNER RECORDATION CERTIFICATE**  
**Filing Requirement of Act 74, Mich. P.A. 1970**

For corners in

Luce	Located In:	Corner Code #
<small>(County)</small>		
1. Public Land Survey	T <u>46</u> R <u>11</u> W	<u>H2</u>
	T <u>   </u> R <u>   </u>	<u>   </u>
	T <u>   </u> R <u>   </u>	<u>   </u>
	T <u>   </u> R <u>   </u>	<u>   </u>
2. Property Controlling in Section	S <u>3</u> T <u>46</u> R <u>11</u> W	<u>15</u>
	S <u>   </u> T <u>   </u> R <u>   </u>	<u>   </u>
3. Miscellaneous Property in Sec.	S <u>   </u> T <u>   </u> R <u>   </u>	<u>   </u>
	S <u>   </u> T <u>   </u> R <u>   </u>	<u>   </u>

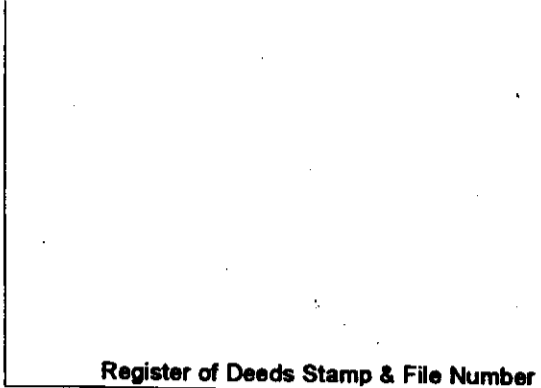

4. Lot No. \_\_\_\_\_, Recorded Plat \_\_\_\_\_  
 5. Private Claims \_\_\_\_\_

15 Oct 31 2002  
 H2 Oct 21 2002

I, Stephan J. Szyszkoski, in a field survey on \_\_\_\_\_, 20\_\_\_\_ do hereby state that under requirements of P.A. 74, Michigan P.A. of 1970, the corner points mentioned in lines 1 and 2 above were in conformance with regulations and rules therefore as required in the current manual of survey instructions of the United States Department of the Interior, Bureau of Land Management or by a decree of a Court of Law and /or that the corner points mentioned in lines 3, 4 and 5 above were in conformance with the rules of the Michigan Board of Land Surveyors or by a Decree of a Court of Law, established, re-established, monumented, recovered, found as expressed below:


NOTE: Not more than 2 corners, all in the same town and range, may be recorded on this certificate.

A	B	C	D	E	F	G	H	I	J	K	L	M
1												
2	6	5	4				●		2		1	
3							●					
4	7	8	9	10	11	12						
5												
6	18	17	16	15	14	13						
7												
8	19	20	21	22	23	24						
9												
10	30	29	28	27	26	25						
11												
12	31	32	33	34	35	36						
13												

A. Description of original monument and accessories and/or subsequent restoration:  
 (H2) Center of Section 3. Not established in the original survey. Found no subsequent record.  
 (15-Sec. 3) West 1/16 corner between Sections 3 and 10. Not established in the original survey. Found no subsequent record.

B. Description of corner evidence found and/or method applied in restoring or reestablishing corner:  
 (H2) Established the corner at the intersection of straight lines connecting opposite 1/4 corners.  
 (15-Sec. 3) Established the corner midway and on a line of mean true bearing between Section corner 1315.33' West and Quarter corner 1315.33' East.

C. Description of monument for corner and accessories established to perpetuate locating the position of the corner:  
 (H2) Set 1"IDx36" I.pipe with 4" alum. MDNR cap. Blazed, scribed, and set measuring nails in:  
 6" Maple N17W 7.35' "CS BT"  
 10" Maple N20E 11.0' do  
 8" Maple S70E 16.15' do  
 6" Maple S18E 13.0' do  
 Set cedar post adjacent. Bearings are magnetic. Distances are to nail with tag.  
 (15) Set 1"IDx36" I.pipe with 4" alum. MDNR cap. Blazed, scribed, and set measuring nails in:  
 10" Maple S74E 5.7' "W1/16 BT"  
 6" Maple N11W 14.25' do  
 8" Maple S79W 17.85' do  
 10" Maple S16W 10.95' do  
 Set cedar post adjacent. Bearings are magnetic. Distances are to nail with tag.

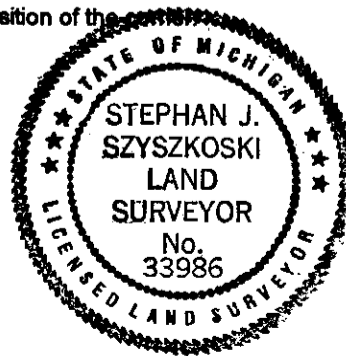

Signed by Stephan J. Szyszkoski  
 Surveyor's Michigan License No. 33986

Date 12/10/02