


LAND CORNER RECORDATION CERTIFICATE
Filing Requirement of Act 74, Mich. P.A. 1970

For corners in

<u>Luce</u> <small>(County)</small>	Located In:	Corner Code #	
1. Public Land Survey	T <u>46N</u> R <u>11W</u>	<u>I2</u>	
	T _____ R _____	_____	
	T _____ R _____	_____	
	T _____ R _____	_____	
2. Property Controlling in Section	S _____ T _____ R _____	_____	
	S _____ T _____ R _____	_____	
3. Miscellaneous Property in Sec.	S _____ T _____ R _____	_____	
	S _____ T _____ R _____	_____	

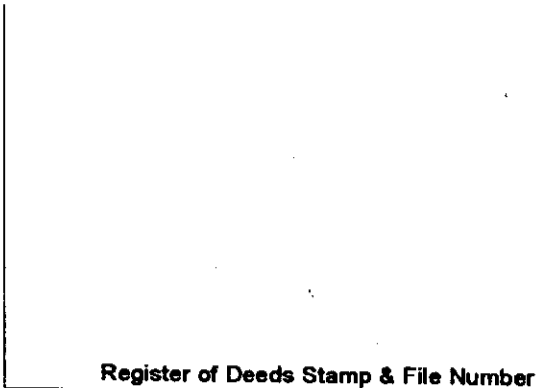

4. Lot No. _____, Recorded Plat _____
 5. Private Claims _____

Sep 17 2002

I, Stephan J. Szyszkoski, in a field survey on _____, 20__ do hereby state that under requirements of P.A. 74, Michigan P.A. of 1970, the corner points mentioned in lines 1 and 2 above were in conformance with regulations and rules therefore as required in the current manual of survey instructions of the United States Department of the Interior, Bureau of Land Management or by a decree of a Court of Law and /or that the corner points mentioned in lines 3, 4 and 5 above were in conformance with the rules of the Michigan Board of Land Surveyors or by a Decree of a Court of Law, established, re-established, monumented, recovered, found as expressed below:

NOTE: Not more than 2 corners, all in the same town and range, may be recorded on this certificate.


A	B	C	D	E	F	G	H	I	J	K	L	M
1												
2	6	5	4	3	2	1						
3												
4	7	8	9	10	11	12						
5												
6	18	17	16	15	14	13						
7												
8	19	20	21	22	23	24						
9												
10	30	29	28	27	26	25						
11												
12	31	32	33	34	35	36						
13												

A. Description of original monument and accessories and/or subsequent restoration:
 (I2) Quarter corner common to Sections 2-3. 1851- Established by Francis Colman: S39°E corr. btwn secs. 2 & 3...39.74 Set qr. sec. post. Hem. 9 N44E 33, Beech 8 S34W 29 ...79.74 Set post corner of secs 2,3,10,11. Found no subsequent record.

B. Description of corner evidence found and/or method applied in restoring or reestablishing corner:
 (I2) The original post and accessories were not recovered. Found no evidence of subsequent monumentation on the ground. Reestablished the corner on a straight line between Section corners 2653.08' south and 2635.83' north, being proportionate to the original record. I observed the true bearing of this line to be S 00 deg 35' 43" E.

C. Description of monument for corner and accessories established to perpetuate locating the position of the corner:

(I12) Set 1"IDx36" I.pipe with 4" alum. HDNR cap. Blazed, scribed, and set measuring nails in:
 18" W.Pine S27W 19.3' "1/4S N8T"
 8" W.Pine N40E 22.75' do
 6" W.Pine N11E 28.35' do
 6" Spruce N70W 11.5' do
 Placed a wood post adjacent. Bearings are magnetic. Distances are to nail with tag.

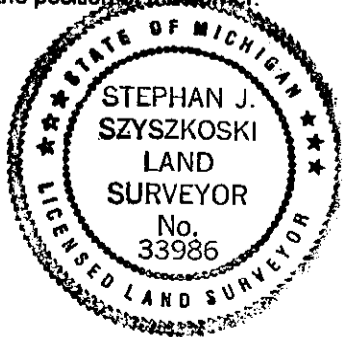

Signed by Stephan J. Szyszkoski
 Surveyor's Michigan License No. 33986

Date 12/10/02