


**LAND CORNER RECORDATION CERTIFICATE**  
**Filing Requirement of Act 74, Mich. P.A. 1970**

For corners in

Luce	Located In:	Corner Code #
<small>(County)</small>		
1. Public Land Survey	T <u>46N</u> R <u>11W</u>	<u>62</u>
	T _____ R _____	_____
	T _____ R _____	_____
	T _____ R _____	_____
2. Property Controlling in Section	S _____ T _____ R _____	_____
	S _____ T _____ R _____	_____
3. Miscellaneous Property in Sec.	S _____ T _____ R _____	_____
	S _____ T _____ R _____	_____

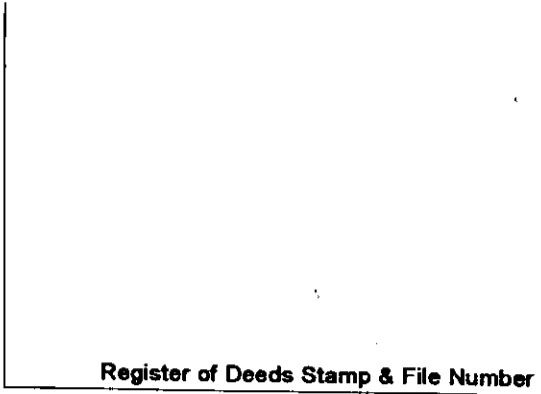

4. Lot No. \_\_\_\_\_, Recorded Plat \_\_\_\_\_  
 5. Private Claims \_\_\_\_\_

Oct 23 2002

I, Stephan J. Szyszkoski, in a field survey on \_\_\_\_\_, 20\_\_ do hereby state that under requirements of P.A. 74, Michigan P.A. of 1970, the corner points mentioned in lines 1 and 2 above were in conformance with regulations and rules therefore as required in the current manual of survey instructions of the United States Department of the Interior, Bureau of Land Management or by a decree of a Court of Law and /or that the corner points mentioned in lines 3, 4 and 5 above were in conformance with the rules of the Michigan Board of Land Surveyors or by a Decree of a Court of Law; established, re-established, monumented, recovered, found as expressed below:

**NOTE: Not more than 2 corners, all in the same town and range, may be recorded on this certificate.**

A	B	C	D	E	F	G	H	I	J	K	L	M
1												
2	6		5		4	●	3		2		1	
3												
4	7		8		9		10		11		12	
5												
6	18		17		16		15		14		13	
7												
8	19		20		21		22		23		24	
9												
10	30		29		28		27		26		25	
11												
12	31		32		33		34		35		36	
13												

**A. Description of original monument and accessories and/or subsequent restoration:**  
 (G2) Quarter corner common to Sections 3-4. 1851- Established by Francis Colman: S57°E corrected btwn Secs 3 & 4...39.46 Set qr. sec. post. W.Birch 6 N21W 21, Maple 6 S67E 47...79.46 Cor. of secs 3,4,9, & 10. Found no subsequent record.

**B. Description of corner evidence found and/or method applied in restoring or reestablishing corner:**  
 (G2) The original post and accessories were not recovered. Found no evidence of subsequent monumentation on the ground. Reestablished the corner on a straight line between Section corners 2655.74' south and 2619.89' north, being proportionate to the original record. I observed the true bearing of this line to be S 00 deg 57' 25" E.

**C. Description of monument for corner and accessories established to perpetuate locating the position of the corner:**

(G2) Set 1"IDx36" I.pipe with 4" alum. MDNR cap. Blazed, scribed, and set measuring nails in:  
 16" Maple N64E 2.25'      "1/4S NBT"  
 12" Maple N02W 12.15'      do  
 14" Maple S78W 15.8'      do  
 14" Maple S05W 15.35'      do  
 Placed cedar post adjacent. Bearings are magnetic. Distances are to nail with tag.



Signed by Stephan J. Szyszkoski  
 Surveyor's Michigan License No. 33986

Date 12/10/02