


**LAND CORNER RECORDATION CERTIFICATE**  
**Filing Requirement of Act 74, Mich. P.A. 1970**

For corners in

Luce	Located In:	Corner Code #
<small>(County)</small>		
1. Public Land Survey	T 46N R 11W	J1
	T R	
	T R	
	T R	
2. Property Controlling in Section	S T R	
	S T R	
3. Miscellaneous Property in Sec.	S T R	
	S T R	

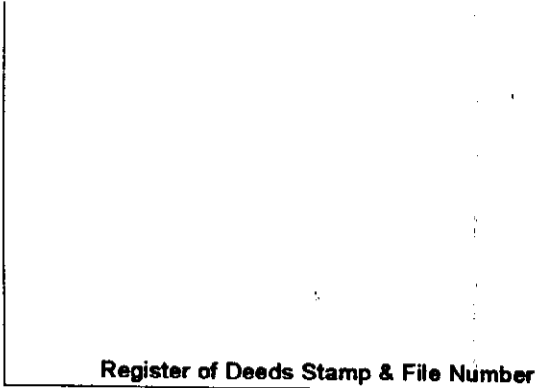

4. Lot No. \_\_\_\_\_, Recorded Plat \_\_\_\_\_  
 5. Private Claims \_\_\_\_\_

Oct 21 2002

I, Stephan J. Szyszkoski, in a field survey on \_\_\_\_\_, 20\_\_ do hereby state that under requirements of P.A. 74, Michigan P.A. of 1970, the corner points mentioned in lines 1 and 2 above were in conformance with regulations and rules therefore as required in the current manual of survey instructions of the United States Department of the Interior, Bureau of Land Management or by a decree of a Court of Law and /or that the corner points mentioned in lines 3, 4 and 5 above were in conformance with the rules of the Michigan Board of Land Surveyors or by a Decree of a Court of Law; established, re-established, monumented, recovered, found as expressed below:


**NOTE:** Not more than 2 corners, all in the same town and range, may be recorded on this certificate.

	A	B	C	D	E	F	G	H	I	J	K	L	M
1										●			
2		6		5		4		3		2		1	
3													
4		7		8		9		10		11		12	
5													
6		18		17		16		15		14		13	
7													
8		19		20		21		22		23		24	
9													
10		30		29		28		27		26		25	
11													
12		31		32		33		34		35		36	
13													

**A. Description of original monument and accessories and/or subsequent restoration:**  
 (J1) Quarter corner common to Section 2 T46N-R11W and Section 35 T47N-R11W. 1841-Established by John Burt for Mm. A. Burt: West on south side Section 35...40.00 Set qr Section post. W. Pine 22 N35E 12, Fir 10 N29W 13. 1960-Re monumented by Billy D. Buckler RLS: This corner was replaced from one probable B.T. a White Pine bearing N35E 12 links. Tree down and in poor condition. Found a notch on this tree which could have been part of bottom blaze. Corner lies 25 links north of road. At the corner, Mr. Buckler placed a 1" pipe with 4" brass cap and marked witnesses: 14" W.Pine N28E 22 links, 14" W.Spruce S20E 86.5 links.

**B. Description of corner evidence found and/or method applied in restoring or reestablishing corner:**  
 (J1) Found the 1960 monument as described, with a MI Dept. of Conservation cap, in good condition, and at substantial record bearing and distance from the 1960 W.Pine NBT, in good condition, with blazes overgrown. The W.Spruce NBT is gone. I accept the monument and make new witnesses as described below.

**C. Description of monument for corner and accessories established to perpetuate locating the position of the corner:**  
 (J1) Found 1" I.pipe with 4" brass MI Dept. of Conservation cap. Blazed, scribed, and set measuring nails in:  
 30" W.Pine N32E 15.25' "1/4S NBT" \*  
 6" W.Pine S68W 10.4' do  
 8" Spruce S85E 28.3' do  
 8" W.Pine S16E 29.55' do  
 Placed cedar post adjacent. Bearings are magnetic. Distances are to nail with tag. \* denotes 1960 witness tree.

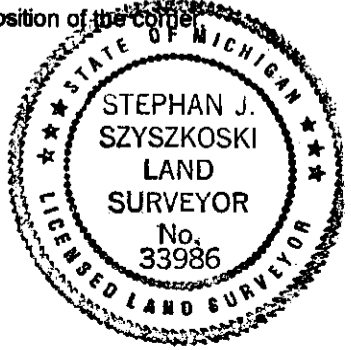

Signed by Stephan J. Szyszkoski  
 Surveyor's Michigan License No. 33986

Date 12/10/02