


LAND CORNER RECORDATION CERTIFICATE
Filing Requirement of Act 74, Mich. P.A. 1970

For corners in

| | | |
|---------------------------------------|--|---------------|
| Luce | Located In: | Corner Code # |
| <small>(County)</small> | | |
| 1. Public Land Survey | T <u>46</u> R <u>11</u> W | <u>13</u> |
| | T <u> </u> R <u> </u> | <u> </u> |
| | T <u> </u> R <u> </u> | <u> </u> |
| | T <u> </u> R <u> </u> | <u> </u> |
| 2. Property Controlling in Section | S <u> </u> T <u> </u> R <u> </u> | <u> </u> |
| | S <u> </u> T <u> </u> R <u> </u> | <u> </u> |
| 3. Miscellaneous Property in Sec. | S <u> </u> T <u> </u> R <u> </u> | <u> </u> |
| | S <u> </u> T <u> </u> R <u> </u> | <u> </u> |

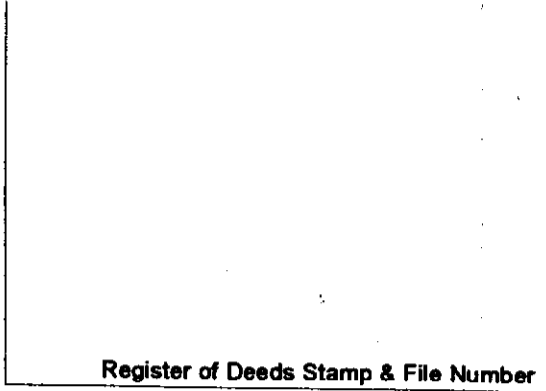

4. Lot No. _____, Recorded Plat _____
 5. Private Claims _____

Sep 18 2002

I, Stephan J. Szyszkoski, in a field survey on _____, 20____ do hereby state that under requirements of P.A. 74, Michigan P.A. of 1970, the corner points mentioned in lines 1 and 2 above were in conformance with regulations and rules therefore as required in the current manual of survey instructions of the United States Department of the Interior, Bureau of Land Management or by a decree of a Court of Law and /or that the corner points mentioned in lines 3, 4 and 5 above were in conformance with the rules of the Michigan Board of Land Surveyors or by a Decree of a Court of Law; established, re-established, monumented, recovered, found as expressed below:


NOTE: Not more than 2 corners, all in the same town and range, may be recorded on this certificate.

| | | | | | | | | | | | | | |
|----|----|---|----|---|----|---|----|---|----|---|----|---|---|
| | A | B | C | D | E | F | G | H | I | J | K | L | M |
| 1 | | | | | | | | | | | | | |
| 2 | 6 | | 5 | | 4 | | 3 | | 2 | | 1 | | |
| 3 | | | | | | | | | ● | | | | |
| 4 | 7 | | 8 | | 9 | | 10 | | 11 | | 12 | | |
| 5 | | | | | | | | | | | | | |
| 6 | 18 | | 17 | | 16 | | 15 | | 14 | | 13 | | |
| 7 | | | | | | | | | | | | | |
| 8 | 19 | | 20 | | 21 | | 22 | | 23 | | 24 | | |
| 9 | | | | | | | | | | | | | |
| 10 | 30 | | 29 | | 28 | | 27 | | 26 | | 25 | | |
| 11 | | | | | | | | | | | | | |
| 12 | 31 | | 32 | | 33 | | 34 | | 35 | | 36 | | |
| 13 | | | | | | | | | | | | | |

A. Description of original monument and accessories and/or subsequent restoration:
 (I3) Corner common to Sections 2-3-10-11. 1851- Established by Francis Colman: S39°E corr. btwn secs 2 & 3...79.74 Set post cor of secs 2,3,10 & 11. Beech 8 N40W 13, Hem. 14 S47E 5. 1960- Remonumented by Billy D. Buckler RLS: This corner was replaced as set by J. McLaren, Newberry. Found wood post and probable Beech 8.T. bearing N40W 13 links. Tree green and standing, has been chopped out. No scribe marks. Found Yellow Birch line tree 10.63 chains south of corner. This tree has been cut and is laying on the ground, we could not determine what stump the log came from. At the corner, Mr. Buckler placed a 1" pipe with 4" brass cap and the following NBTS: 13" Beech N21W 38.5 links, 12" Hemlock N44E 52.5 links, 10" Hemlock S12E 40.5 links.

B. Description of corner evidence found and/or method applied in restoring or reestablishing corner:
 (I3) Recovered the 1960 monument in good condition, with a MI Dept. of Conservation tablet, at substantial record bearing and distance from the 1960 NBTS, the Hemlocks in good condition with overgrown blazes, and the Beech dead but standing. The probable OBT Beech N40W 13 links is a rotted stump at record bearing and distance. Distances west (79.72 M, 79.25 R) and north (80.13 M, 79.74 R) are nearly equally long with respect to the record. I accept the monument and make new witnesses as described below.

C. Description of monument for corner and accessories established to perpetuate locating the position of the corner:
 (I3) Found 1" ID I.pipe with 4" brass MI Dept. of Conservation cap. Blazed, scribed, and set measuring nails in:
 16" Hemlock N52E 35.0' "S2" *
 14" Hemlock S11E 26.65' "S11" *
 5" Beech S34W 11.2' "S10 NBT"
 6" Maple N75W 15.15' "S3 NBT"
 Bearings are magnetic. Distances are to nail with tag. * denotes 1960 NBT.

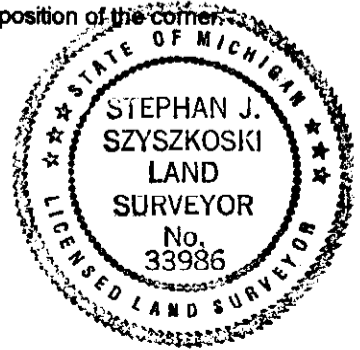

Signed by Stephan J. Szyszkoski
 Surveyor's Michigan License No. 33986

Date 12/10/02