



SKETCH
OF
SEC. 14, T. 46 N. R. 12 W.
LUCE CO.

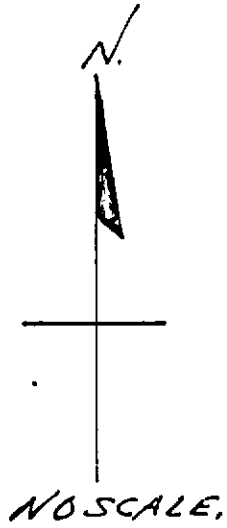

R. = S. 89° 15' E, 5,236.44'
S. 89° 12' 30" E, 5,257.64'

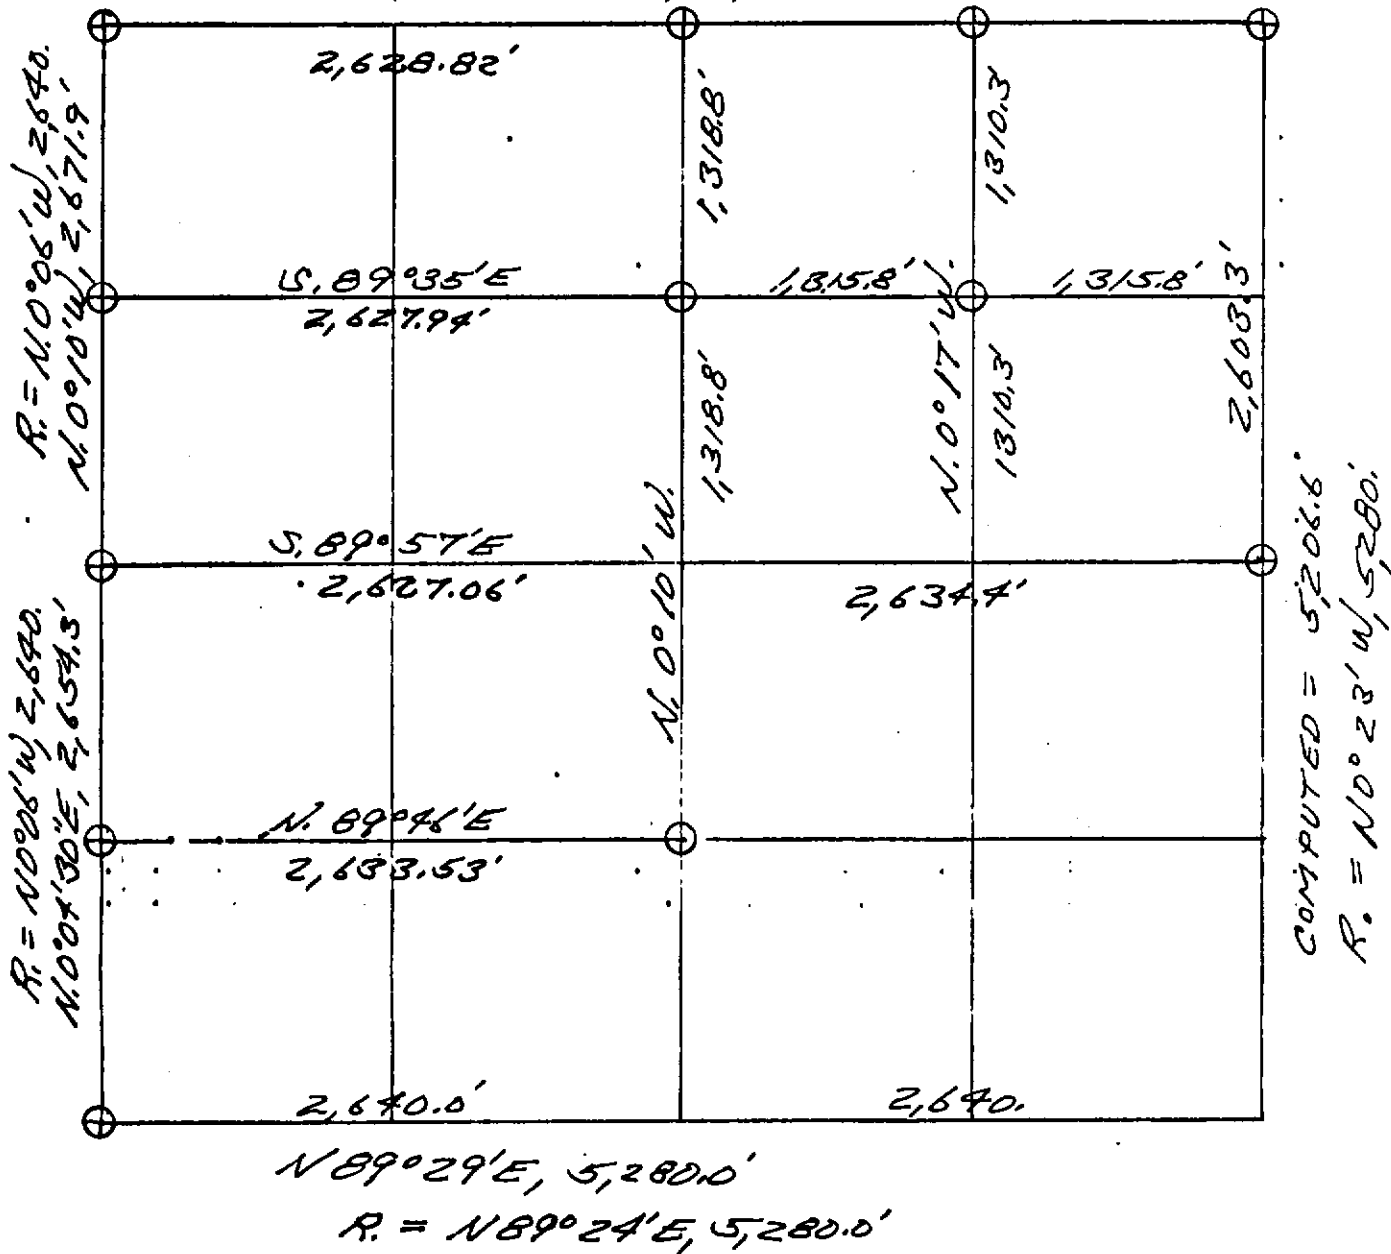

9-12-78

Billy D. Buchler
 REG. LAND SURVEYOR.
 # 6887.