

LAND CORNER RECORDATION CERTIFICATE
Filing Requirement of Act 74, Mich. P.A. 1970

For corners in

Luce			
_____	Located In:	Corner Code #	
(County)			
1. Public Land Survey	T <u>46N</u> R <u>12W</u>	<u>C3</u>	_____
	T _____ R _____	_____	_____
	T _____ R _____	_____	_____
	T _____ R _____	_____	_____
2. Property Controlling in Section	S _____ T _____ R _____	_____	_____
	S _____ T _____ R _____	_____	_____
3. Miscellaneous Property in Sec.	S _____ T _____ R _____	_____	_____
	S _____ T _____ R _____	_____	_____

Register of Deeds Stamp & File Number

4. Lot No. _____, Recorded Plat _____
 5. Private Claims _____

Sep 14 2004

I, Stephan J. Szyszkoski, in a field survey on _____, 19____ do hereby state that under requirements of P.A. 74, Michigan P.A. of 1970, the corner points mentioned in lines 1 and 2 above were in conformance with regulations and rules therefore as required in the current manual of survey instructions of the United States Department of the Interior, Bureau of Land Management or by a decree of a Court of Law and /or that the corner points mentioned in lines 3, 4 and 5 above were in conformance with the rules of the Michigan Board of Land Surveyors or by a Decree of a Court of Law, established, re-established, monumented, recovered, found as expressed below:

NOTE: Not more than 2 corners, all in the same town and range, may be recorded on this certificate.

A	B	C	D	E	F	G	H	I	J	K	L	M
1												
2	6	5		4		3		2		1		
3		●										
4	7	8		9		10		11		12		
5												
6	10	17		16		15		14		13		
7												
8	19	20		21		22		23		24		
9												
10	30	29		28		27		26		25		
11												
12	31	32		33		34		35		36		
13												


A. Description of original monument and accessories and/or subsequent restoration:
 (C3) Corner common to Sections 5-6-7-8. 1851: Established by Francis Colman. Set post. Y.Pine 18 N25E 53 links, fir 10 S23W 12 links. 1952: Remonumented by Dean C. DeLaMater at record bearing and distance from original BT Y.Pine, still in place, fair condition. Set 1" pipe with 4" brass cap. New witnesses: 24" W.Pine stump S60W 74 links, 15" R.Pine stump S65E 72 links.

B. Description of corner evidence found and/or method applied in restoring or reestablishing corner:

(C3) Found the 1952 monument in good condition and at record bearing and distance from the 1952 stump witnesses. Scribing on the stump SW is still readable. Original BT Y.Pine NE still in place, at record bearing and distance, evidence of old blaze but no scribe marks visible.

C. Description of monument for corner and accessories established to perpetuate locating the position of the corner:

(C3) Found 1" Iron pipe with 4" brass cap. Set nails with tags in:
 10" R.Pine N32W 42.9' mrkd "S6 NBT"
 8" J.Pine S86E 16.35' "S8 NBT"
 6" J.Pine S27E 48.15' "S8 NBT"
 8" J.Pine S30W 42.75' "S7 NBT"
 Bearings are magnetic. Distances are to nail with tag.

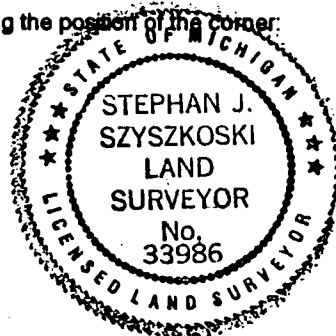

Signed by Stephan J. Szyszkoski
 Surveyor's Michigan License No. 33986

Date 3/15/05