


LAND CORNER RECORDATION CERTIFICATE
 Filing Requirement of Act 74, Mich. P.A. 1970

For corners in

Luce	Located in:	Corner Code #	
(County)			
1. Public Land Survey	T <u>46N</u> R <u>12W</u>	<u>E1</u>	
	T ___ R ___	_____	
	T ___ R ___	_____	
	T ___ R ___	_____	
2. Property Controlling in Section	S ___ T ___ R ___	_____	
	S ___ T ___ R ___	_____	
3. Miscellaneous Property in Sec.	S ___ T ___ R ___	_____	
	S ___ T ___ R ___	_____	

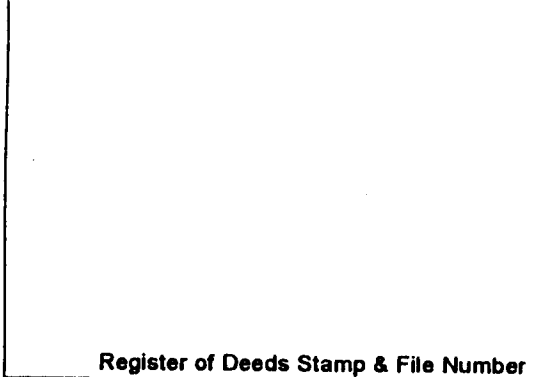

4. Lot No. _____, Recorded Plat _____
 5. Private Claims _____

Sep 14 2004

I, Stephan J. Szyszkoski, in a field survey on _____, 19____ do hereby state that under requirements of P.A. 74, Michigan P.A. of 1970, the corner points mentioned in lines 1 and 2 above were in conformance with regulations and rules therefore as required in the current manual of survey instructions of the United States Department of the Interior, Bureau of Land Management or by a decree of a Court of Law and /or that the corner points mentioned in lines 3, 4 and 5 above were in conformance with the rules of the Michigan Board of Land Surveyors or by a Decree of a Court of Law; established, re-established, monumented, recovered, found as expressed below:

NOTE: Not more than 2 corners, all in the same town and range, may be recorded on this certificate.

A	B	C	D	E	F	G	H	I	J	K	L	M
1												
2	6		5		4		3		2		1	
3												
4	7		8		9		10		11		12	
5												
6	18		17		16		15		14		13	
7												
8	19		20		21		22		23		24	
9												
10	30		29		28		27		26		25	
11												
12	31		32		33		34		35		36	
13												

A. Description of original monument and accessories and/or subsequent restoration:
 (E1) Corner common to Sections 4-5 T46N-R12W and 32-33 T47N-R12W. 1841: Established by John Burt. Set post. W.Pine 34 N50E 51, W.Pine 9 N46W 46. 1952: Remonumented by Dean C. DeLaMater. Notes in field book at DNR office at Newberry: "found iron (H.Lawrence) scribed post, fallen over, but original location identifiable at base. B.T. W.P. stump N50E 51, B.T. W.P. stump S59E 52". Set 1" pipe with 4" brass cap. 7" Jack Pine S36W 26 links, 26" W.Pine stump S55E 51 links.

B. Description of corner evidence found and/or method applied in restoring or reestablishing corner:
 (E1) Found and accepted the 1952 monument at record bearing and distance from the 1952 witnesses. Made new witnesses as described below.

C. Description of monument for corner and accessories established to perpetuate locating the position of the corner:
 (E1) Found 1" ID I. pipe with 4" brass cap. Set nails with tags in:
 18" J.Pine S40W 16.95' mrkd "S5" *
 10" J.Pine S65W 8.1' mrkd "S5 NBT"
 6" J.Pine N21W 13.5' "S32 NBT"
 12" J.Pine S50E 32.15' "S4 NBT"
 Bearings are magnetic. Distances are to nail with tag. * denotes 1952 NBT.



Signed by Stephan J. Szyszkoski
 Surveyor's Michigan License No. 33986

Date 3/15/05