

LAND CORNER RECORDATION CERTIFICATE
Filing Requirement of Act 74, Mich. P.A. 1970 as Amended

For corners in

<u>Luce</u> <small>(County)</small>	Located In:	Corner Code #
1. Public Land Survey	T <u>46N</u> R <u>12W</u>	<u>F1</u>
	T <u>47N</u> R <u>12W</u>	<u>F13 (Same Corner)</u>
	T _____ R _____	_____
2. Property Controlling in Section	S _____ T _____ R _____	_____
	S _____ T _____ R _____	_____
3. Miscellaneous Property in Sec.	S _____ T _____ R _____	_____
	S _____ T _____ R _____	_____
4. Lot No. _____, Recorded Plat _____		
5. Private Claims		

Register of Deeds Stamp & File Number

	A	B	C	D	E	F	G	H	I	J	K	L	M
1						●							
2	6		5		4		3		2		1		
3													
4	7		8		9		10		11		12		
5													
6	18		17		16		15		14		13		
7													
8	19		20		21		22		23		24		
9													
10	30		29		28		27		26		25		
11													
12	31		32		33		34		35		36		
13													

T46N R12W

Aug 15 2006

I, Stephan J. Szyszkoski, in a field survey on _____, 20__ do hereby state that under requirements of P.A. 74, Michigan P.A. of 1970, the corner points mentioned in lines 1 and 2 above were in conformance with regulations and rules therefore as required in the current manual of survey instructions of the United States Department of the Interior, Bureau of Land Management or by a decree of a Court of Law and /or that the corner points mentioned in lines 3, 4 and 5 above were in conformance with the rules of the Michigan Board of Land Surveyors or by a Decree of a Court of Law; established, re-established, monumented, recovered, found as expressed below:

NOTE: Not more than 2 corners, all in the same town and range, may be recorded on this certificate.

A. Description of original monument and accessories and/or subsequent restoration:


(F1) Quarter corner common to Section 4 T46N-R12W and Section 33 T47N-R12W. 1841 - Established by Wm. Burt, Deputy Surveyor: West on south side Sec. 33 ...40.00 Set qr. section post. Y.Pine 14 N38E 26, W.Pine 9 N50W 38. 1952 - Dean C. DeLaMater RLS perpetuated the original position and noted in the record: "Two original B.T.'s still in place, fair condition. Set 1" pipe with 4" brass cap. Witnesses to corner: 6" J.Pine S55E 38 links, 6" J.Pine S65W 38 links."

B. Description of corner evidence found and/or method applied in restoring or reestablishing corner:

(F1) Recovered the 1952 monument in good condition. The 1952 NBTs and the original BTs were not recovered. A perpetuated original corner was found at E1 2636.37' west and the reestablished G1 is 2637.41' east. This monument is located 1.1' south of the Township line between E1 and G1. Accepted the monument as the best available evidence of the position of the original corner. The corner lies about 25' north of an E-W trail.

C. Description of monument for corner and accessories established to perpetuate locating the position of the corner:

(F1) Found 1" ID I.pipe with 4" brass MI Dept. of Conservation cap. Set measuring nails in:
 4" J.Pine S77W 12.88' mrd "1/4S NBT"
 6" J.Pine S25W 79.85' do
 5" W.Pine S10E 54.3' do
 7" J.Pine S27E 93.95' do
 Bearings are magnetic. Distances are to nail with MDNR tag.

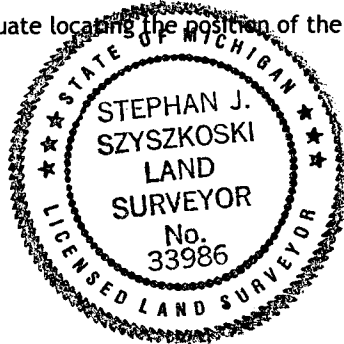

Signed by Stephan J. Szyszkoski Date 12/13/06
 Surveyor's Michigan License No. 33986