LAND CORNER RECORDATION CERTIFICATE
Filing Requirement of Act 74, Mich. P.A. 1970 as Amended

For corners in

Luce (County)

	Located In:			Corner Code #
1. Public Land Survey		T 46N	R 12W	F2
		T	R	
		T	R	
	S	T	R	
2. Property Controlling	S 4	T 46N	R 12W	2
in Section	S	T	R	
3. Miscellaneous	S	T	R	
Property in Sec.	S	T	R	

Register of Deeds Stamp & File Number

4. Lot No. _____ , Recorded Plat_____

5. Private Claims

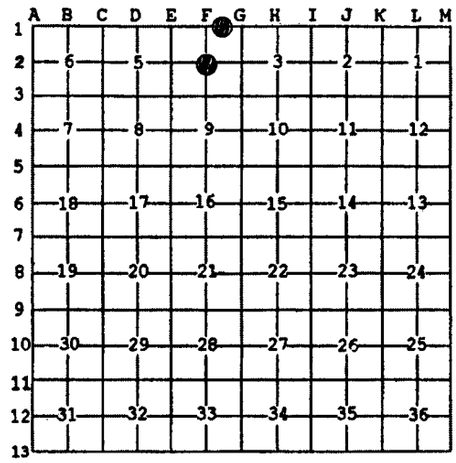

Sep 13 2006

I, Stephan J. Szyszkoski, in a field survey on _____, 20 ____ do hereby state that under requirements of P.A. 74, Michigan P.A. of 1970, the corner points mentioned in lines 1 and 2 above were in conformance with regulations and rules therefore as required in the current manual of survey instructions of the United States Department of the Interior, Bureau of Land Management or by a decree of a Court of Law and /or that the corner points mentioned in lines 3, 4 and 5 above were in conformance with the rules of the Michigan Board of Land Surveyors or by a Decree of a Court of Law; established, re-established, monumented, recovered, found as expressed below:

NOTE: Not more than 2 corners, all in the same town and range, may be recorded on this certificate.

A. Description of original monument and accessories and/or subsequent restoration:

(F2) Center of Section 4. Not established in the original survey. Found no subsequent record.
(2-Sec. 4) East 1/16 corner between Section 4 T46N-R12W and Section 33 T47N-R12W. Not established in the original survey.

B. Description of corner evidence found and/or method applied in restoring or reestablishing corner:

(F2) Established the corner at the intersection of straight lines connecting opposite 1/4 corners. From the position thus established, I found a metal fence post, marking an approximate corner location, N20E 31.8' distant.
(2-Sec. 4) Established the corner on the Township line, midway between Quarter corner 1318.70' west and Section corner 1318.70' east. From the position thus established, I found a metal fence post, marking an approximate corner position, S87E 97' distant.

C. Description of monument for corner and accessories established to perpetuate locating the position of the corner:

(F2) Set 1"IDx36" I.pipe with 4" alum. MDNR cap. Set measuring nails in:

7" J.Pine S31W 11.04'	mrkd "CS BT"
10" J.Pine S20E 13.12'	do
14" J.Pine N08E 13.25'	do
11" J.Pine N61E 53.6'	do

Bearings are magnetic. Distances are to nail with MDNR tag.

(2) Set 1"IDx36" I.pipe with 4" alum. MDNR cap. Set measuring nails in:

7" J.Pine N50W 7.49'	mrkd "E1/16 BT"
8" J.Pine S48W 26.34'	do
12" R.Pine S05W 28.84'	do
15" R.Pine N26E 34.43'	do

Bearings are magnetic. Distances are to nail with tag.

STATE OF MICHIGAN
STEPHAN J. SZYSZKOSKI
LAND SURVEYOR
No. 33986
LICENSED LAND SURVEYOR

Signed by Stephan J. Szyszkoski Date 12/13/06

Surveyor's Michigan License No. 33986

For the Michigan Department of Natural Resources, Office of Land and Facilities

FORM APPROVED BY MICHIGAN STATE BOARD OF PROFESSIONAL SURVEYORS, JAN. 28, 1971
Revised May 14, 1975
Revised Jan., 1983
Rervised Oct., 1995