


LAND CORNER RECORDATION CERTIFICATE
Filing Requirement of Act 74, Mich. P.A. 1970 as Amended

For corners in

<u>Luce</u> <small>(County)</small>	Located In:	Corner Code #
1. Public Land Survey	T <u>46N</u> R <u>12W</u>	<u>F3</u>
	T _____ R _____	_____
	T _____ R _____	_____
2. Property Controlling in Section	S _____ T _____ R _____	_____
	S _____ T _____ R _____	_____
3. Miscellaneous Property in Sec.	S _____ T _____ R _____	_____
	S _____ T _____ R _____	_____
4. Lot No. _____, Recorded Plat _____		
5. Private Claims		

Register of Deeds Stamp & File
Number

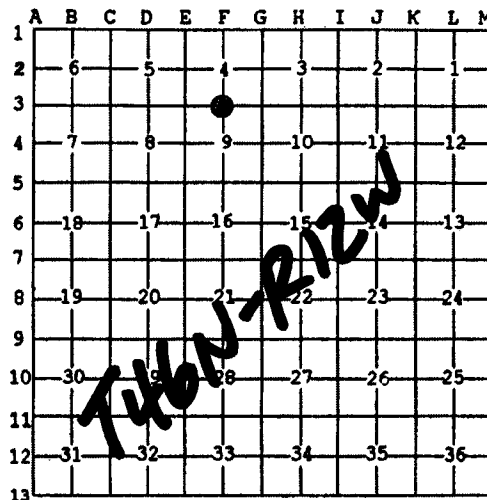

Aug 16 2006

I, Stephan J. Szyszkoski, in a field survey on _____, 20__ do hereby state that under requirements of P.A. 74, Michigan P.A. of 1970, the corner points mentioned in lines 1 and 2 above were in conformance with regulations and rules therefore as required in the current manual of survey instructions of the United States Department of the Interior, Bureau of Land Management or by a decree of a Court of Law and /or that the corner points mentioned in lines 3, 4 and 5 above were in conformance with the rules of the Michigan Board of Land Surveyors or by a Decree of a Court of Law; established, re-established, monumented, recovered, found as expressed below:

NOTE: Not more than 2 corners, all in the same town and range, may be recorded on this certificate.

A. Description of original monument and accessories and/or subsequent restoration:

(F3) Quarter corner common to Sections 4 and 9. 1851 - Established by Francis Colman, Deputy Surveyor: S89 deg. 57'W Corrected between Sections 4 & 9 ...40.24 Set qr. sec. post. Y.Pine 12 N39E 173 links, Y.Pine 12 S30W 59 links; ..80.48 Sec. cor. 1952 - Dean C. DeLaMater RLS perpetuated the original position and stated in the record: "Two original B.T.'s still in place, fair condition. Set 1" pipe with 4" brass cap. Witnesses to corner: 14" Red Pine N6E 66 links, 14" Red Pine S78E 127 links."

B. Description of corner evidence found and/or method applied in restoring or reestablishing corner:

(F3) Recovered the 1952 monument in good condition and at record bearing and distance from the 1952 Red Pine NBTs, both in good condition with scribed, open blazes. The original BTs were not recovered. Accepted the monument as a careful and faithful perpetuation of the position of the original corner. The monument is located 10.6' north of a straight line between monumented and probably original Section corners 2661.64' west and 2630.90' east.

C. Description of monument for corner and accessories established to perpetuate locating the position of the corner:

(F3) Found 1" ID I.pipe with 4" brass MI Dept. of Conservation cap. Set measuring nails in:
 20" R.Pine N11E 43.97' old marks *
 20" R.Pine S71E 84.75' do *
 7" J.Pine West 11.15' mrkd "1/4S NBT"
 9" R.Pine S84E 15.6' do
 Bearings are magnetic. Distances are to nail with MDNR tag. * denotes 1952 NBT.



Signed by Stephan J. Szyszkoski
 Surveyor's Michigan License No. 33986

Date 12/13/06

For the Michigan Department of Natural Resources, Office of Land and Facilities

FORM APPROVED BY MICHIGAN STATE BOARD OF PROFESSIONAL SURVEYORS, JAN. 28, 1971

Revised May 14, 1975

Revised Jan., 1983

Revised Oct., 1995